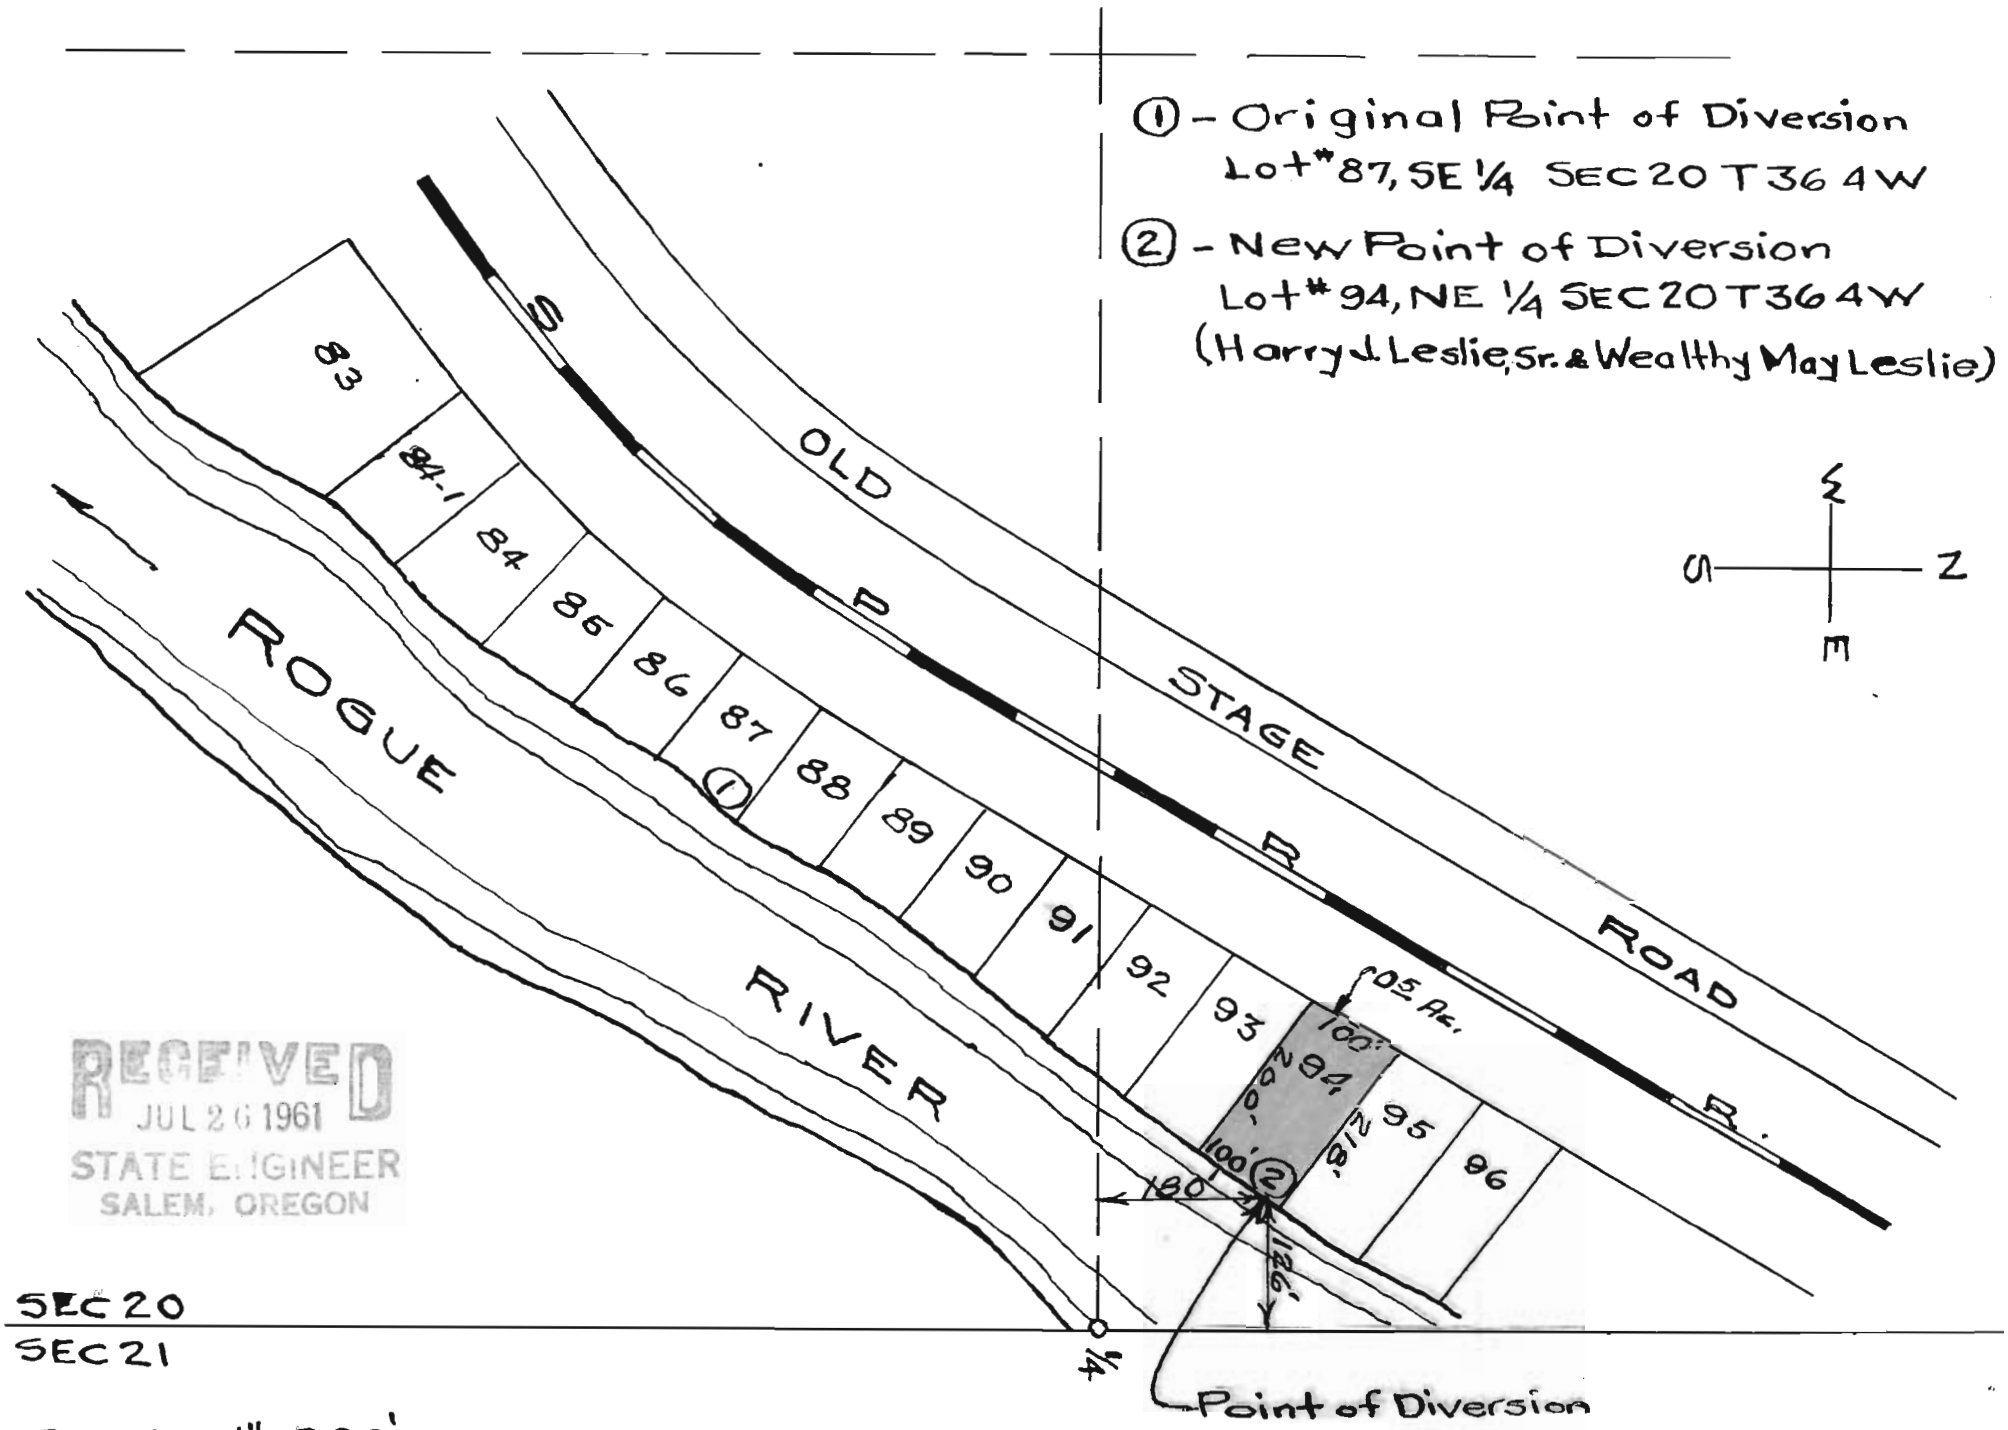

RECEIVED
JUL 26 1961
STATE ENGINEER
SALEM, OREGON

Application No. 35603
Permit No. 27504