


Per. 27563

R-2662

40-8-7

T.40S.R.88.9W.W.M.

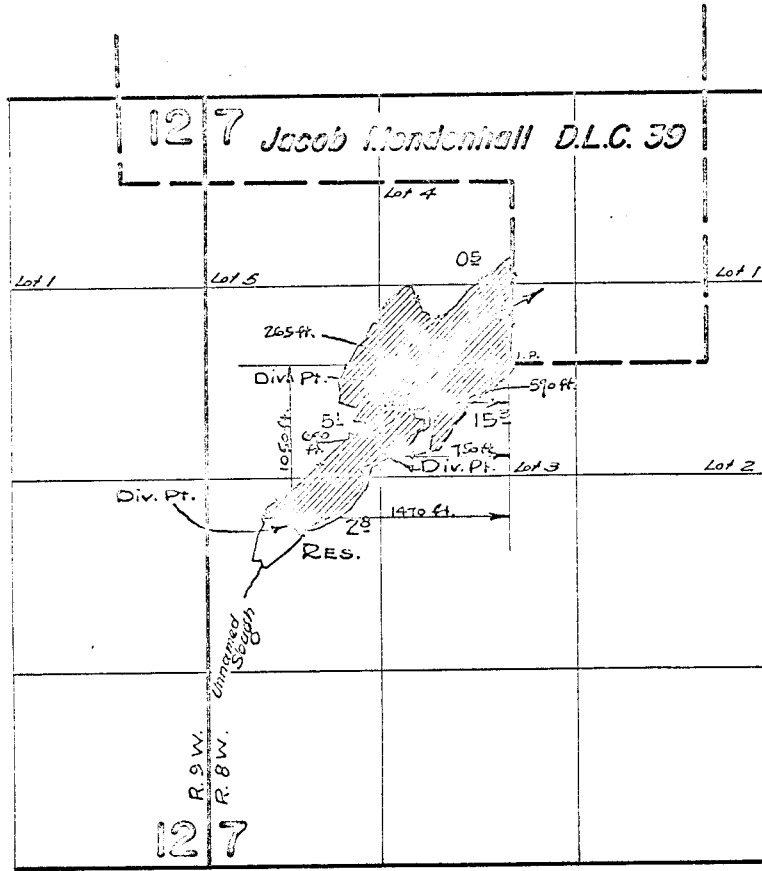

FINAL PROOF SURVEY
UNDER

R-37030 R-2662
Application No. 37031 Permit No. 27563
IN NAME OF

EITEL F. MUSSELMAN

Surveyed June 22 1965, by *A. Jackson*