


Longitude
15

37-7-10

T.37S.R.7W.W.M.

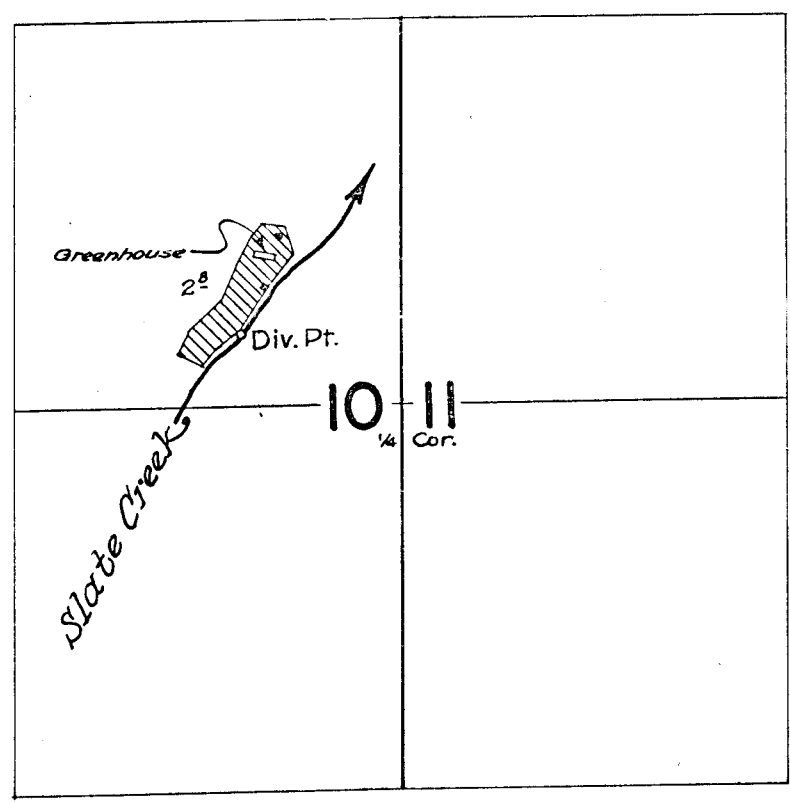

Scale : 1" = 660'

FINAL PROOF SURVEY UNDER

Application No. 37048... Permit No. 27568...
IN NAME OF

MARCELLUS P. FROST

Surveyed July 12, 1963, by *R. Jackson*