


27571 15
34-6-14

T. 34S.R.6W.W.M.

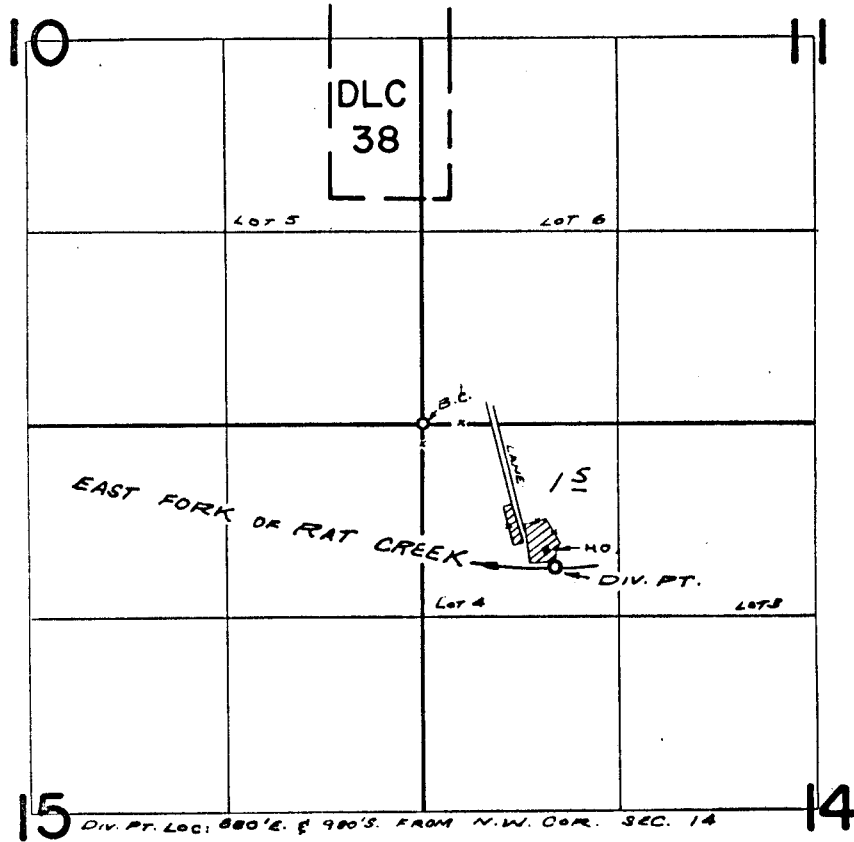

FINAL PROOF SURVEY UNDER

Application No. 37057 Permit No. 27571
IN NAME OF

CARL & FLORENCE WESTMAN

Surveyed APRIL 14 1970, by R. MUCKEN