


# T.13S.R.5W.W.M.

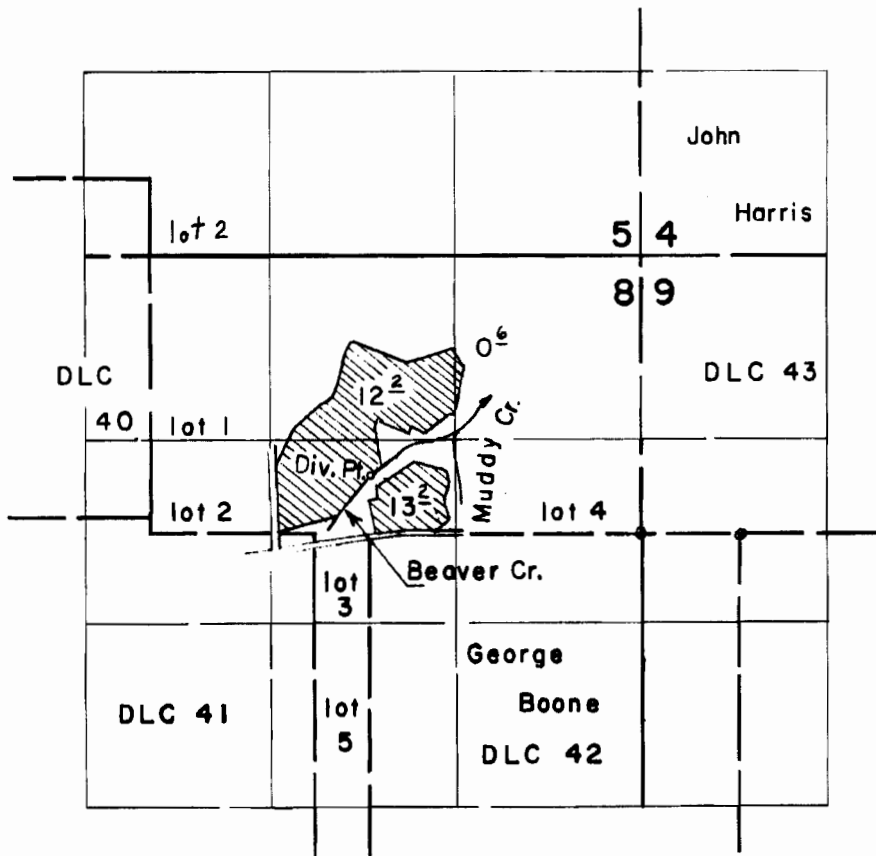

## FINAL PROOF SURVEY UNDER

Application No. 37094.. Permit No. 27612...  
IN NAME OF

..... Vardyn F. & Mary J. Buchanan

Surveyed July 21, 1964, by F. Siegmund...