


Permit: S 27655
Volume: 8A
Strm: A SPR>O'BRIEN CR
Trib: W FK ILLINOIS R
Priority: 12/13/61

T.40S.R.8W.W.M.

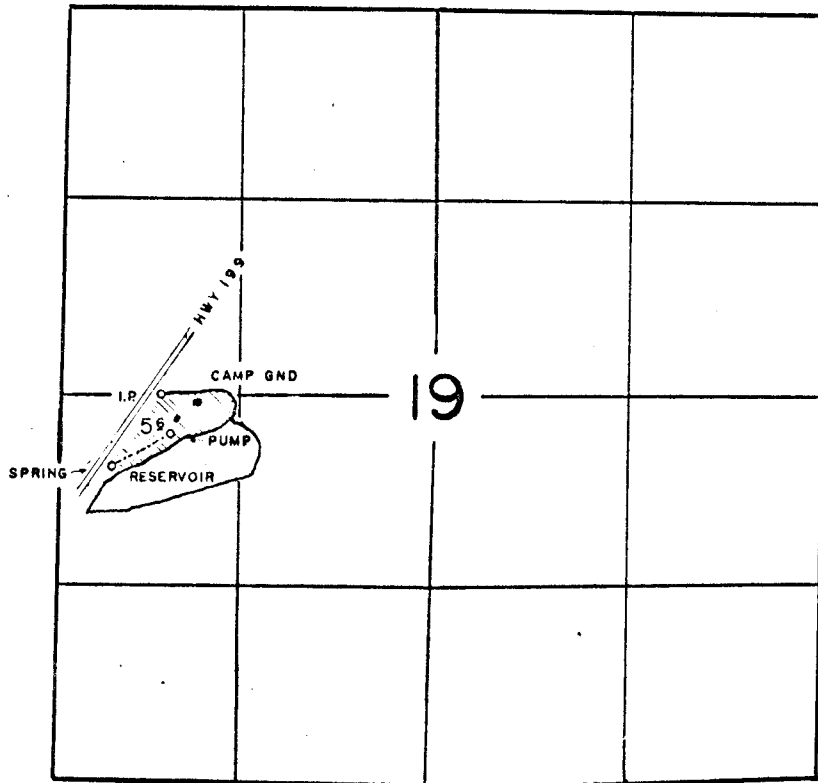

FINAL PROOF SURVEY UNDER

Application No. 37092... Permit No. 27655...
IN NAME OF

.....CHARLIE A. TREFETHEN.....

Surveyed Oct. 21... 1964, by R.B. STELMER..