


① ~~Original Point of Diversion~~

Lot # 87, SE 1/4 SEC. 20 T36 R4 W

② New Point of Diversion

Lot # 93, NE 1/4 SEC 20 T36 R4 W

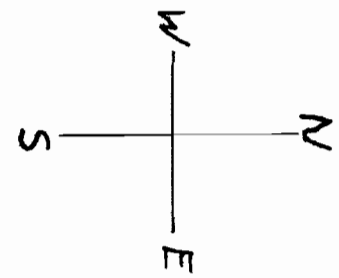


SEC 20
 SEC 21

Scale 1" = 200

Point of Diversion
 Application No. 37101
 Permit No. 27657