


Josephine
15

36-7-14

T.36S.R.7W.W.M

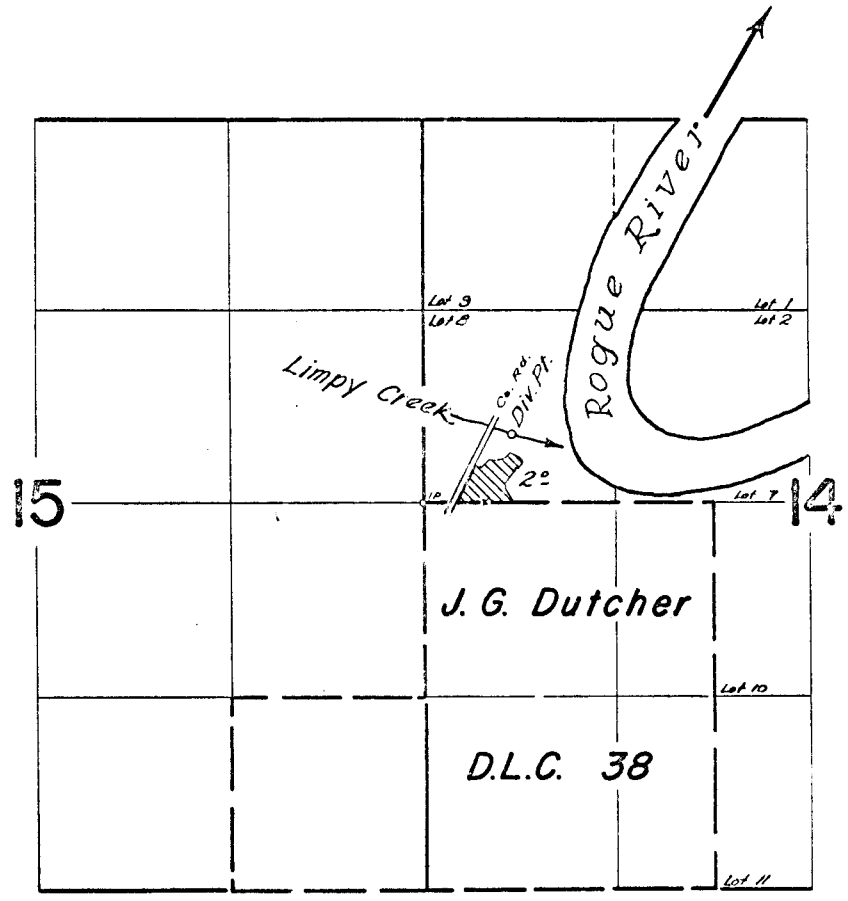

FINAL PROOF SURVEY UNDER

Application No. 37199... Permit No. 27722..
IN NAME OF

MAX & ETHEL NAEF

Surveyed July 11, 1963, by *R. Jackson*