


T.36S.R.5W.W.M.

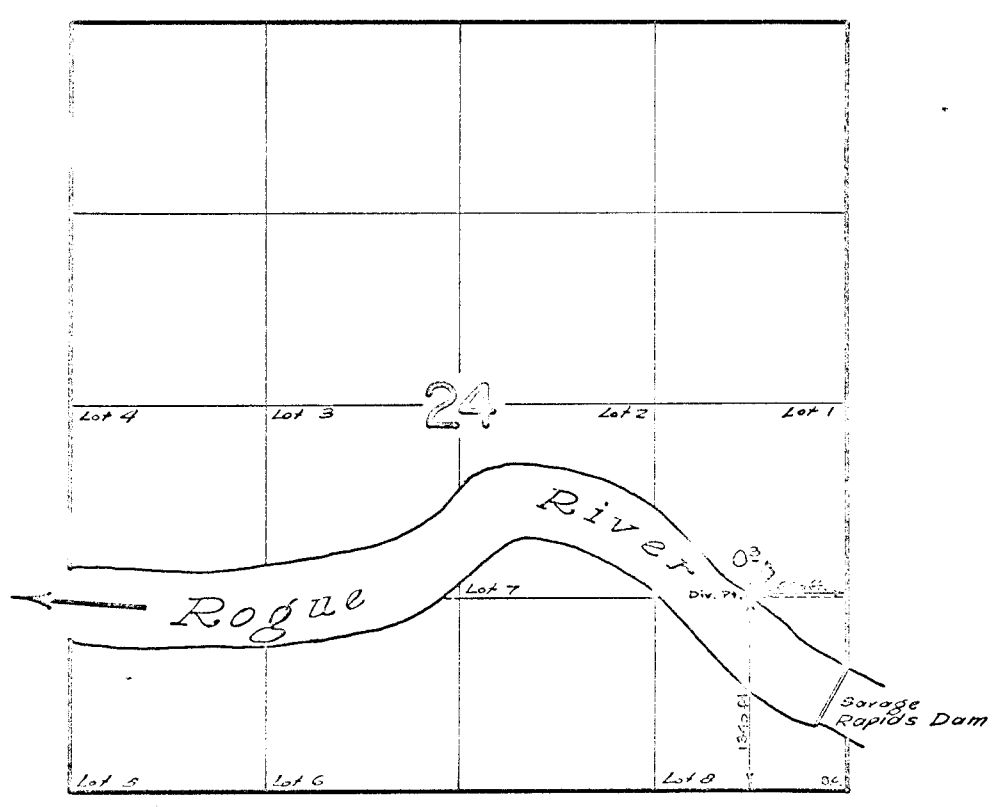

FINAL PROOF SURVEY UNDER

Application No. 37200... Permit No. 27720...
IN NAME OF

SAM D. & EDITH M. PENRY

Surveyed June 30, 1965, by *R. Johnson*