


T.34S.R.7W.W.M.

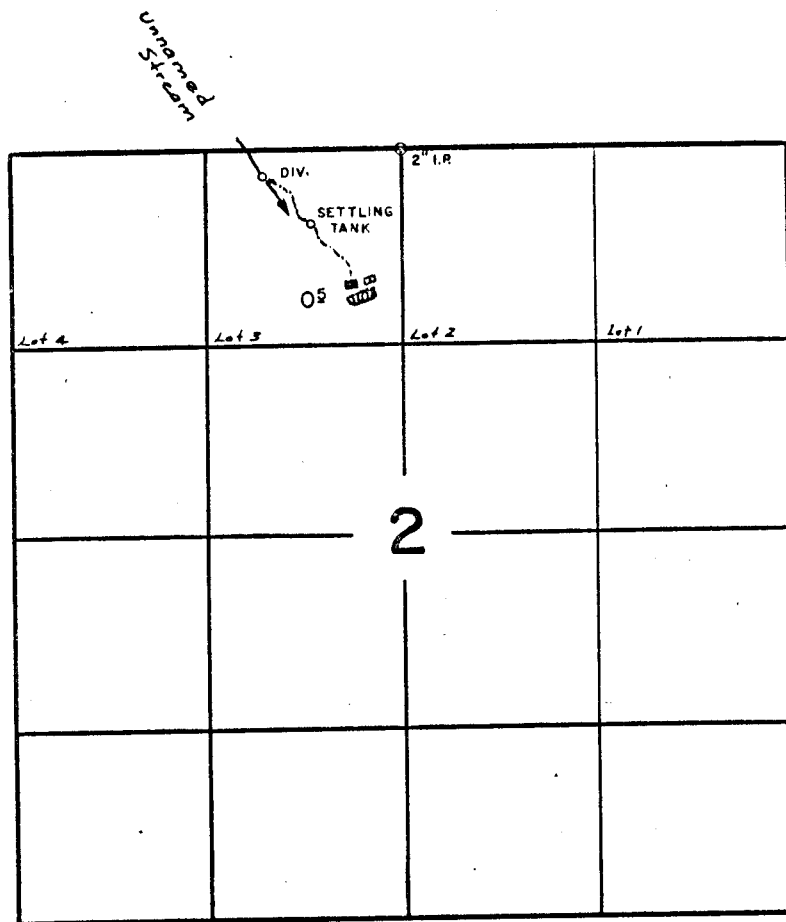

FINAL PROOF SURVEY UNDER

Application No. 37217... Permit No. 27734...
IN NAME OF

JOHN B. H. WICKERSHAM

Surveyed OCT 26 1965, by R. B. STEIMER