

T. 11 S., R. 40 E., W.M.

1" = 300'

800'

15
22

22

23

23

27

26

26

OPERATIONS AREA


1" = 600'

Application No. 37384
Permit No. 27827

TOWNSHIP # 11 S.

RANGE 40 E.W.M.

E

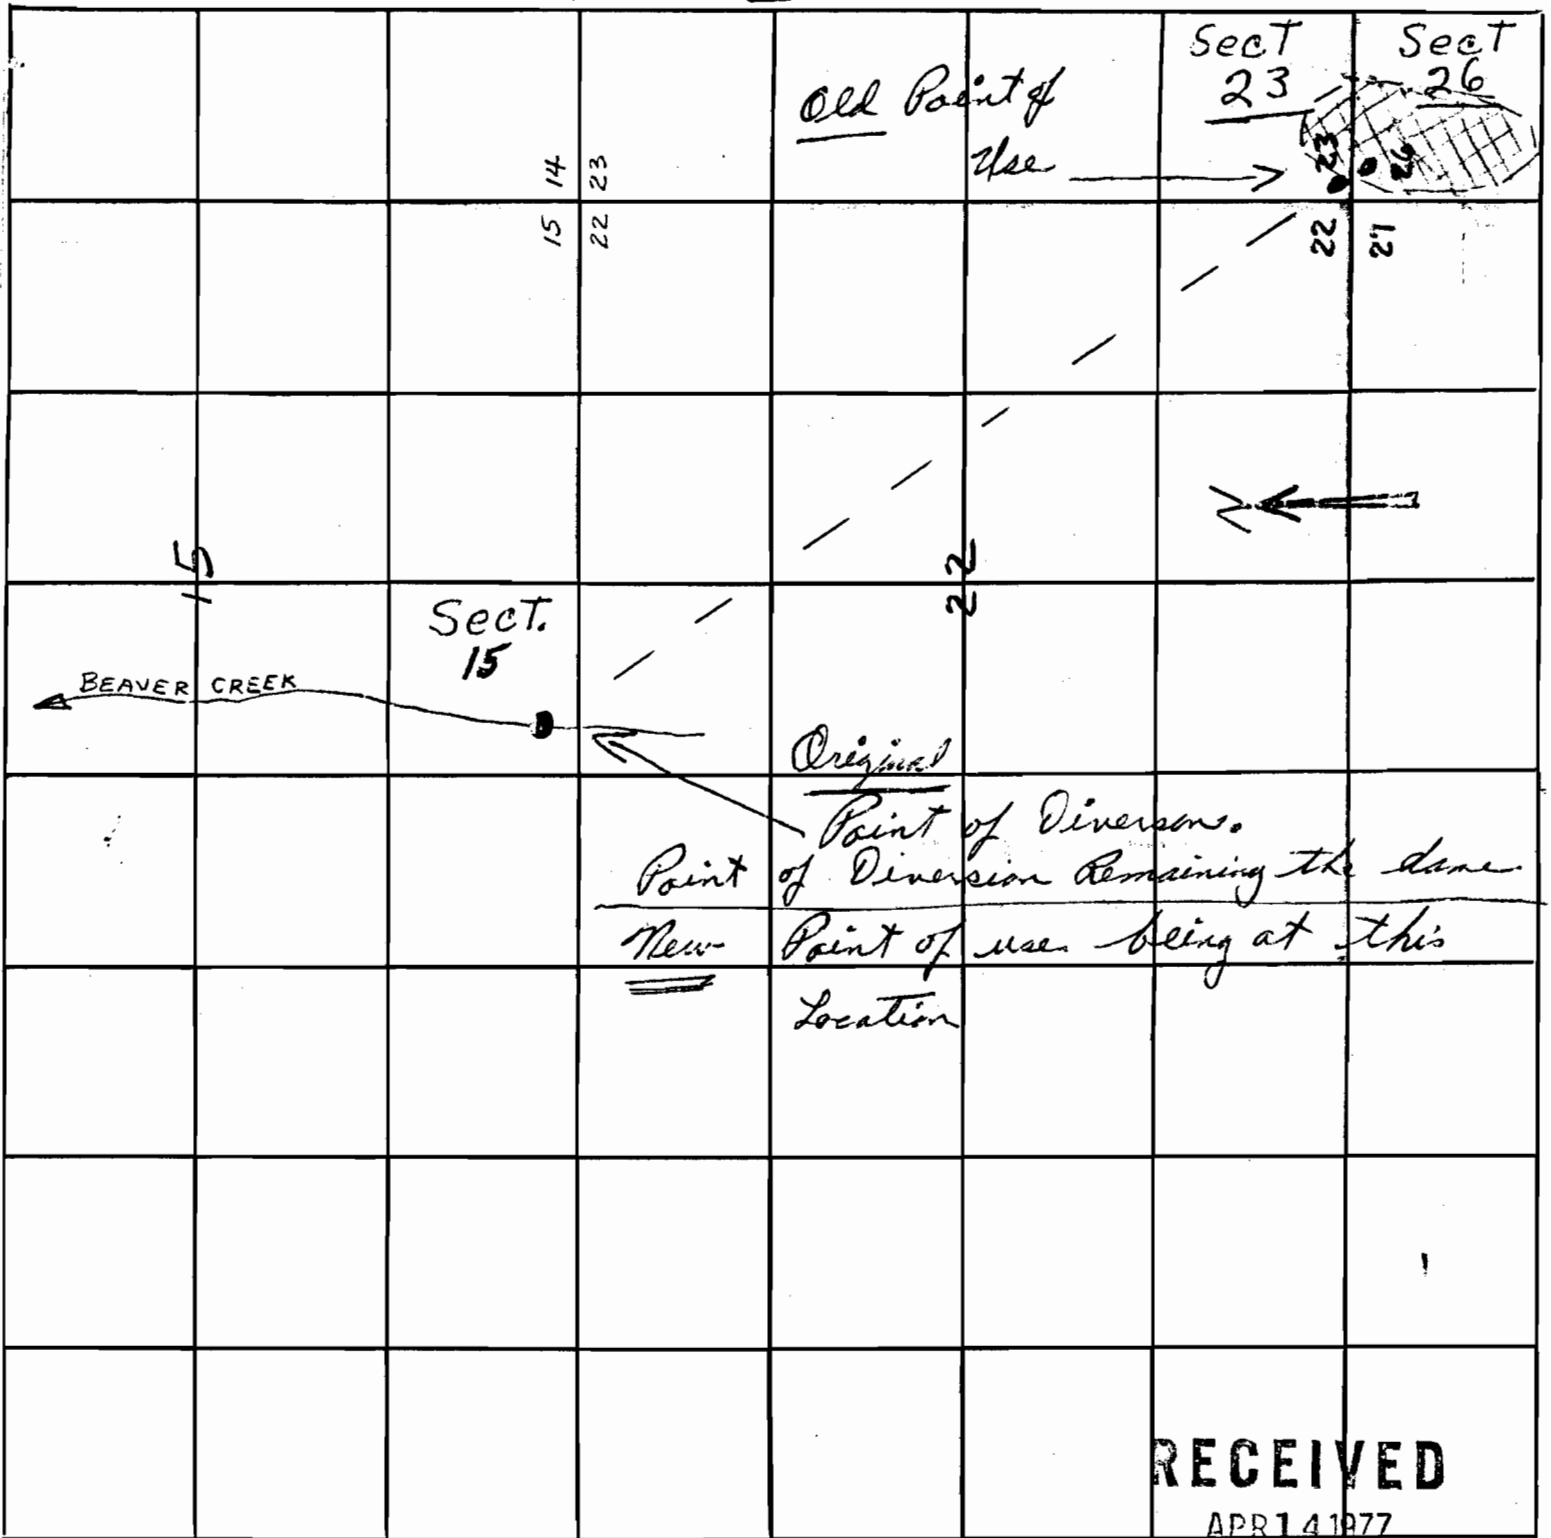

MAP TO ACCOMPANY APPLICATION OF: W

WATER RESOURCES DEPT.
SALEM, OREGON

Name Olen D. Regsdale

County Baker, Baker, Oregon

Date 4-2-77

Scale 4" to 1 Mile

Note:

MAP PREPARED FROM: U.S. Army Engineer-Project Map

MAP DRAWN BY: Olen D. Regsdale

SIGNED BY APPLICANT: Olen D. Regsdale