
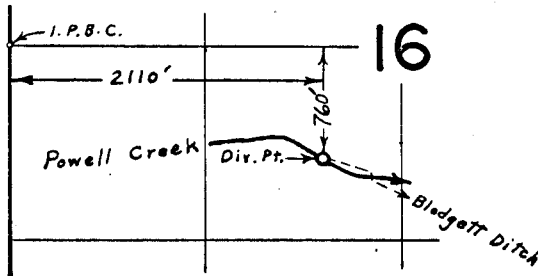


27831

T.38S.R.5 W.W.M.

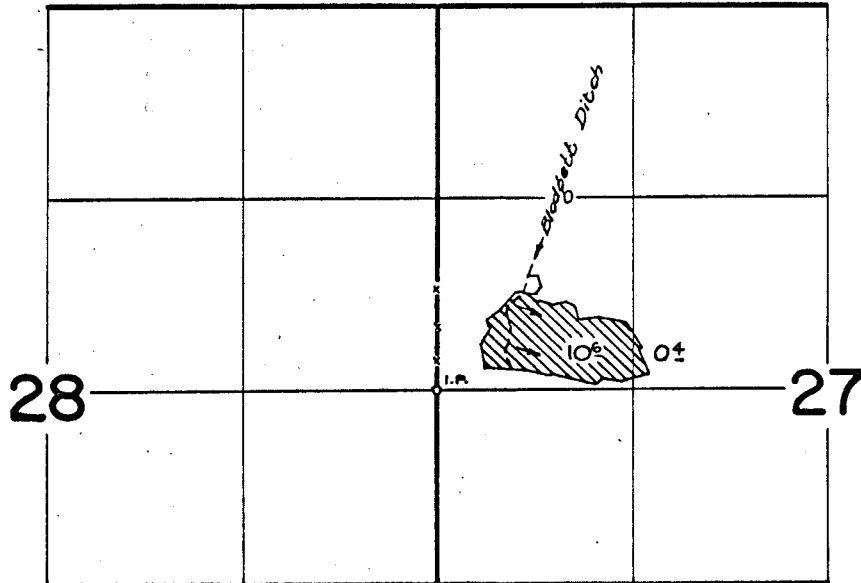

FINAL PROOF SURVEY UNDER

Application No. 37390... Permit No. 27831...
IN NAME OF

AZEL & J. CLEM BLODGETT.

Surveyed June 25, 1965, by *A. Jackson*
(Div. Pt.) Aug. 22, 1967, by *L.E. Gould*