


TWP 36 S R 3 W 11 M

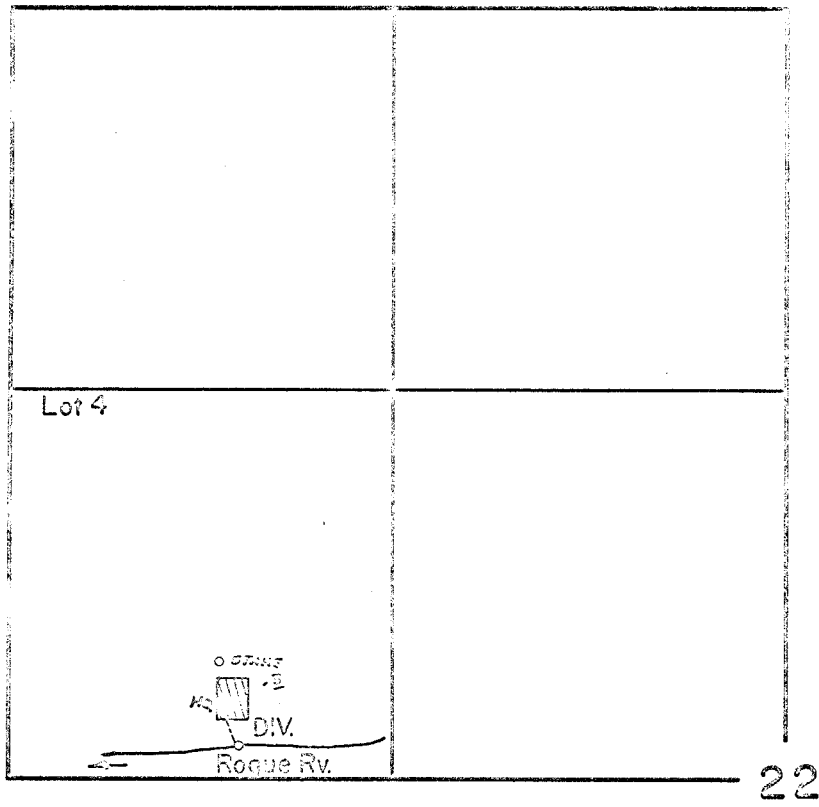

11/2 22 780 1

NW 1/4 SEC 22

Scale 8"=1mi

FINAL PROOF SURVEY
UNDER

Application No. 37410 Permit No. 27062
IN NAME OF

LLOYD E. RING

Surveyed 8-15 1963, by Steimar