


27866  
29173

31-5-17

T. 39S. R. 8W. W.M.

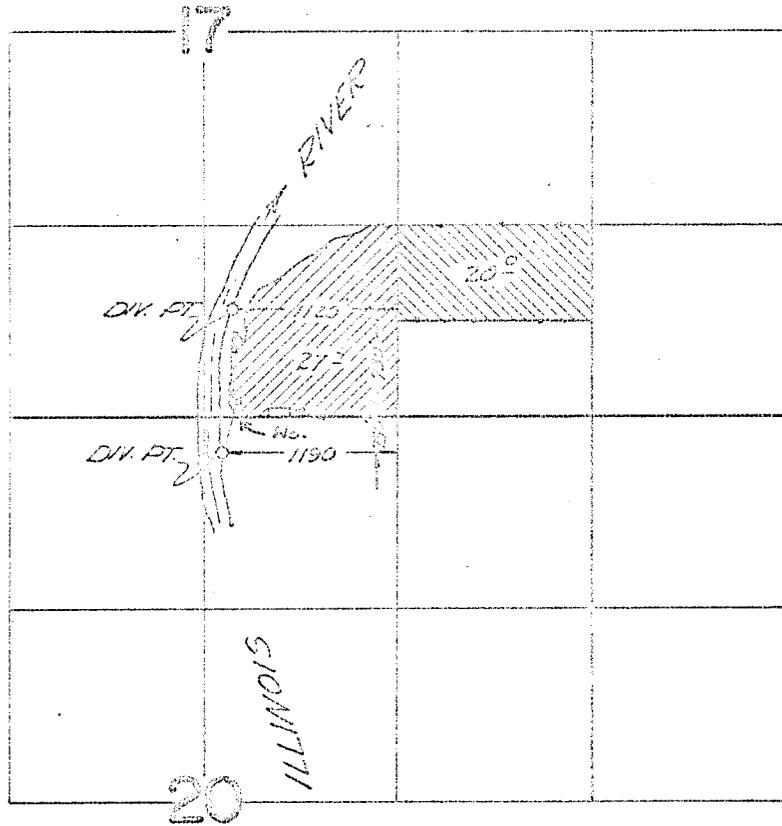

FINAL PROOF SURVEY  
UNDER

37416                      27866   
Application No. 39081      Permit No. 29173   
IN NAME OF

CHARLES NEIL VERSTEEG

Surveyed May 17, 1967, by V. Gacher