


T.37S.R.9W.W.M.

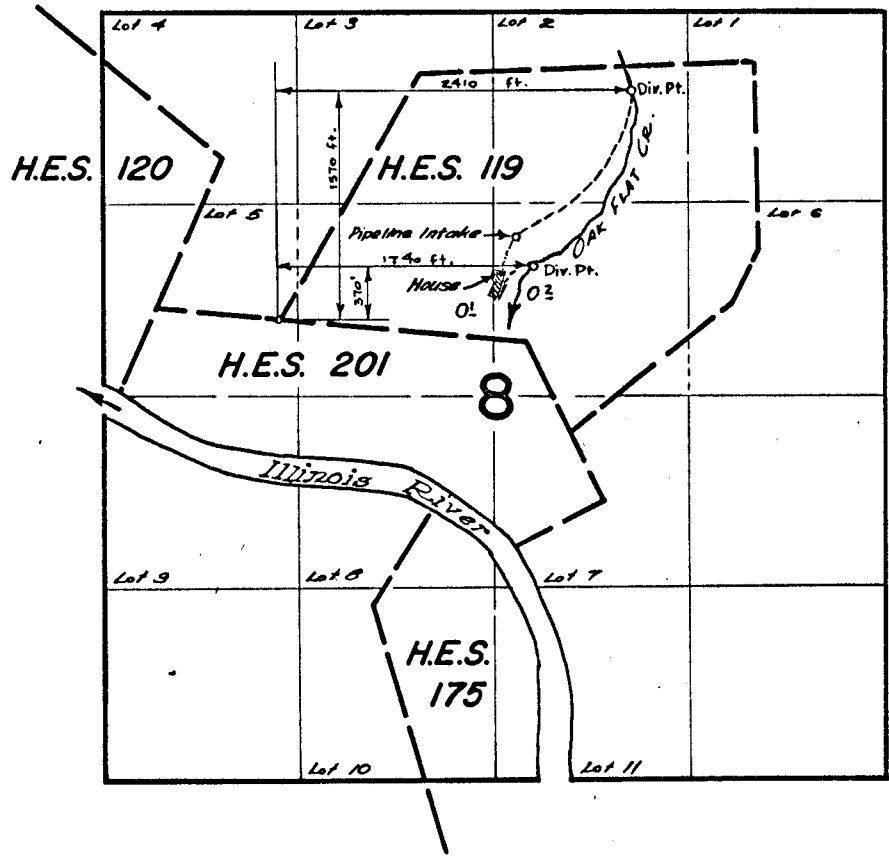

FINAL PROOF SURVEY UNDER

Application No. 37423... Permit No. 27869
IN NAME OF

JAMES & MYRTLE BUCKLIN

Surveyed July 15, 1965, by *A. Jackson*