


This point is S. 2013' & E. 642.9' from N.E. Cor. of the NW $\frac{1}{4}$  of NW $\frac{1}{4}$  of SEC 3.

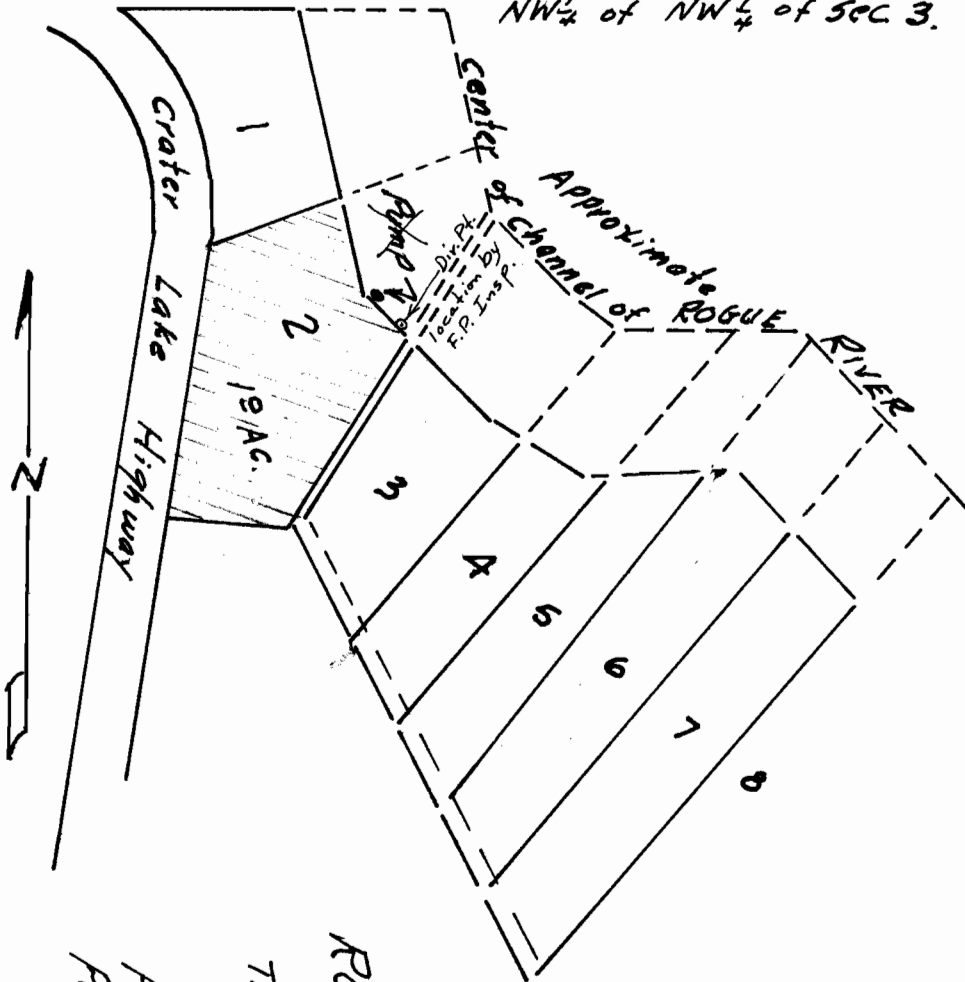

ROGUE ACRES

Section 3

T. 34 S. R. 1 W. N. M.

1" = 200'

Appl. 37452

Per. 27883

COPY

(Mrs. Lauretta Dresser)