


T. 38 S. R. 5 W.W.M.

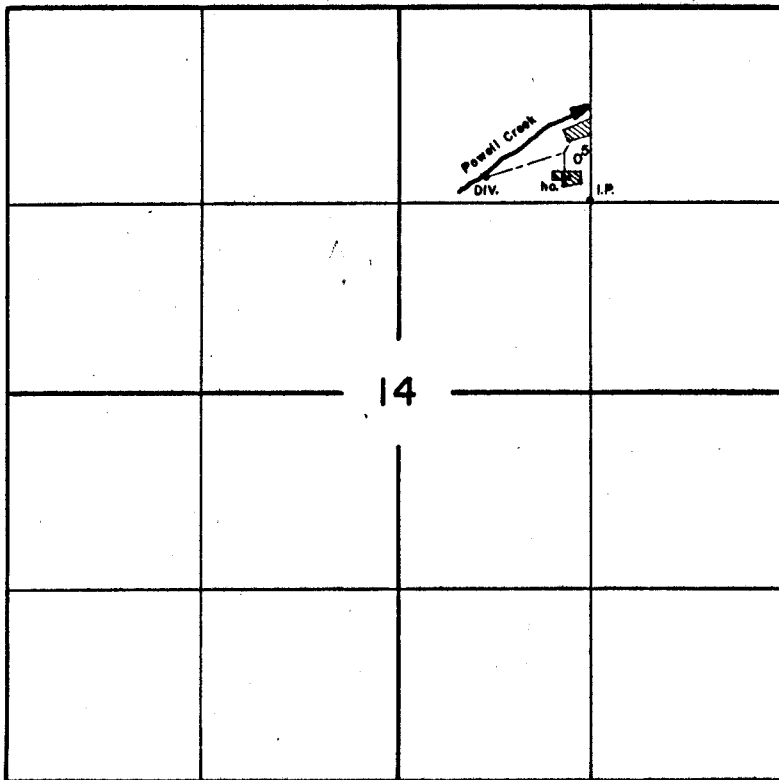

FINAL PROOF SURVEY UNDER

Application No. 37495... Permit No. 27911.....
IN NAME OF

Loren J. B./or Mildred R. Ashmore.....

Surveyed May 22... 1964., by R.B. Steimer.