


# T.39S.R.5W.W.M.

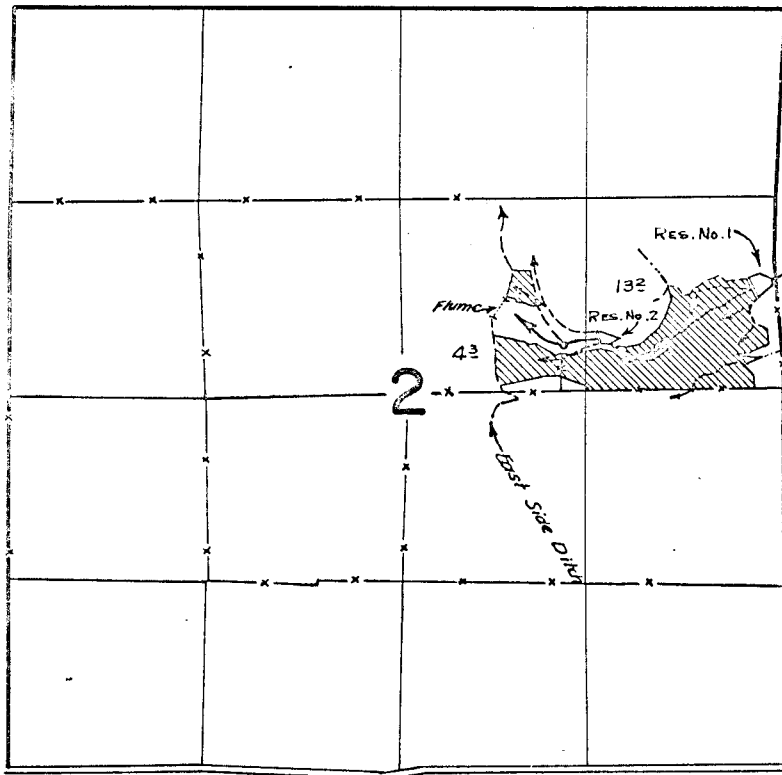

## FINAL PROOF SURVEY UNDER

R-37254

R-2864

Application No. 37255... Permit No. 27926...

IN NAME OF

CLAIRE O. BROWN

Surveyed *July 1*, 1965, by *R. J. Peterson*