


T. 39 S. R. 8 W. W.M.

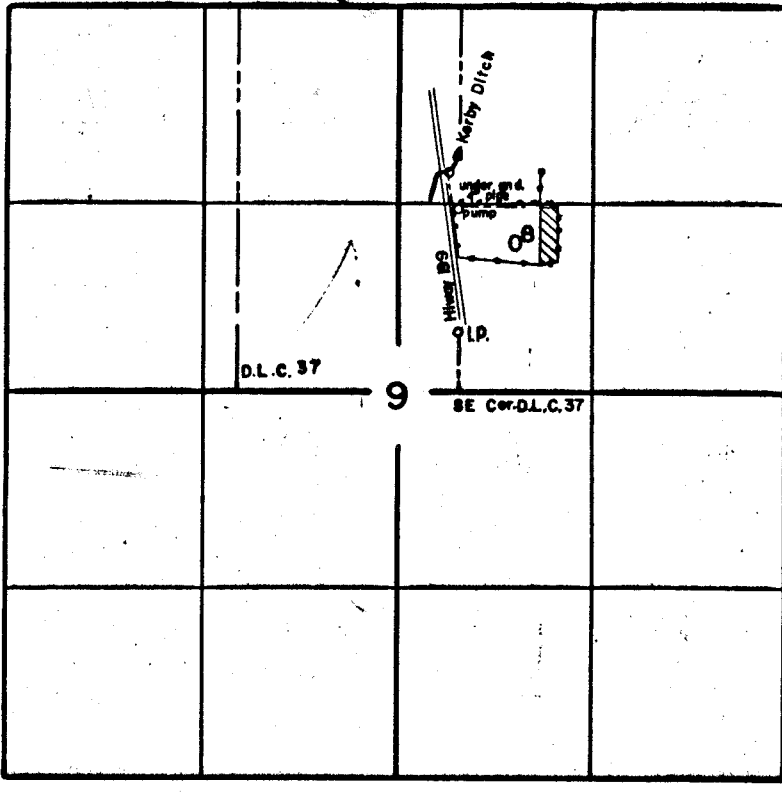


FINAL PROOF SURVEY UNDER

Application No. 37516... Permit No. 27961.....
IN NAME OF

.....KERBY GRADE SCHOOL.....

Surveyed JUNE 26 1964, by R.B. STEIMER.

T. 39 S., R. 8 W., W. M.

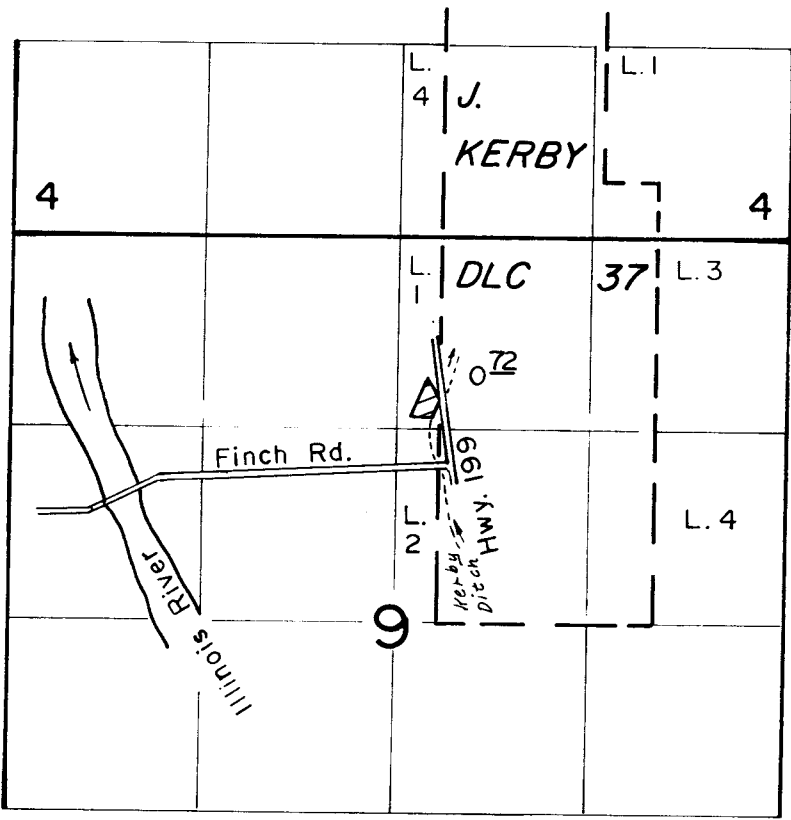

KERBY DITCH DIVERSION:

1650'S., 1800'E. From NW cor. Sec 27

in SE 1/4 NW 1/4 Sec. 27, T. 39 S., R. 8 W. W. M.

Scale: 1" = 1320'

FINAL PROOF SURVEY
UNDER

TRANSFER NO. 4700

Application No. Permit No.
IN NAME OF

BELT BUILDING ASSOC., INC.

Surveyed SEP. 10. 1987., by B. S. JAMES..