


Joseph  
15

37-6-25

T.37S. R.6 W.W.M.

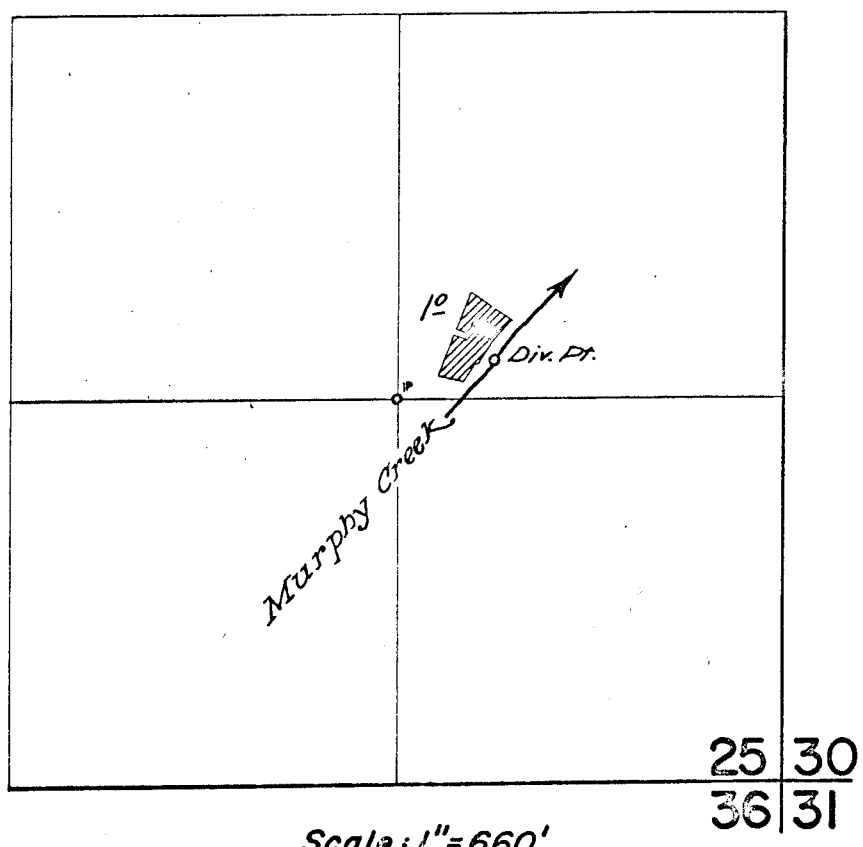

Scale: 1" = 660'

**FINAL PROOF SURVEY**  
UNDER

Application No. 37561... Permit No. 27986...  
IN NAME OF

PRESLEY PYLE

Surveyed July 9, 1963, by *[Signature]*

1963-K

Application No. 37561  
Permit No. 27986