


Joseph
15

34-6-12

T.34S.R.6W.W.M.

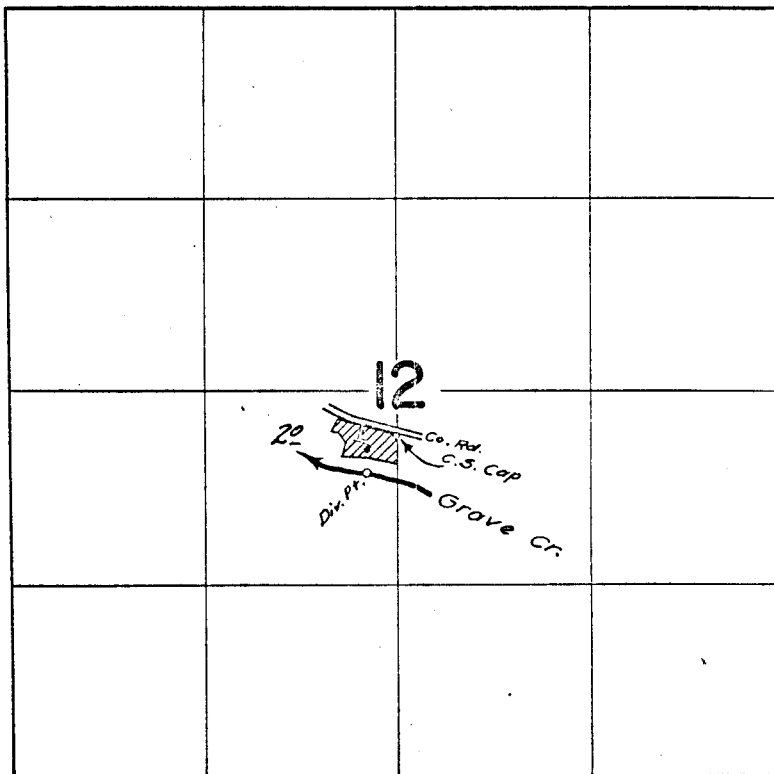

FINAL PROOF SURVEY
UNDER

Application No. 37589 Permit No. 28005
IN NAME OF

MERRILL A. RICHARDSON

Surveyed June 10 1963, by

R. Jackson

1963-K

Permit No. 28005

Creek