


T.36S.R.5W.W.M.

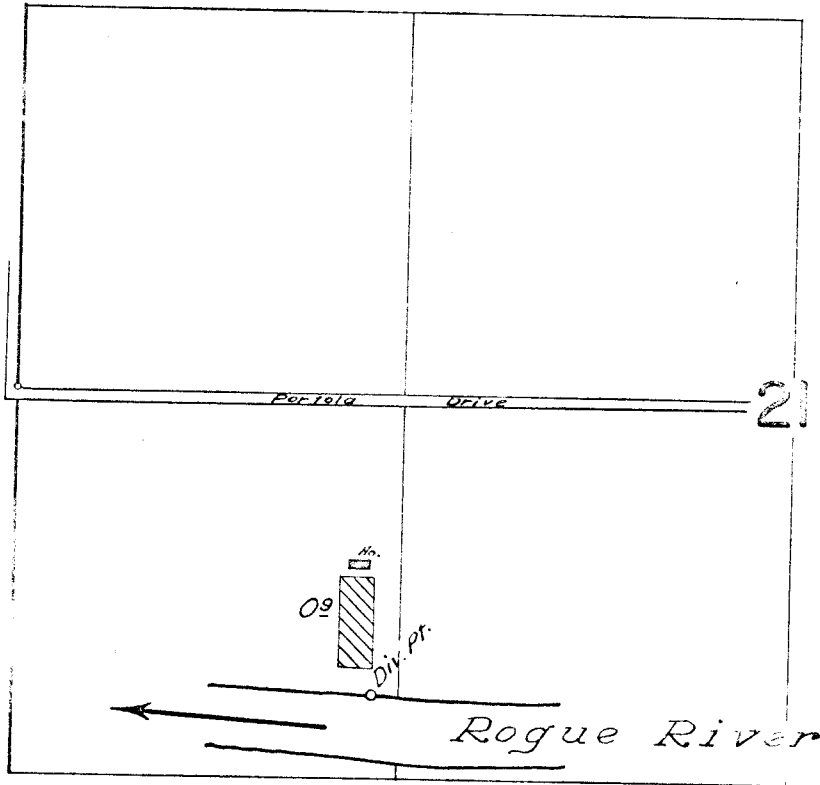

Scale: 1" = 660'

FINAL PROOF SURVEY UNDER

Application No. 37590... Permit No. 28006...
IN NAME OF

J. GIBSON PLEASANTS

Surveyed June 6, 1963, by *R. Jackson*