


T. 39 S. R. 8 W.W.M.

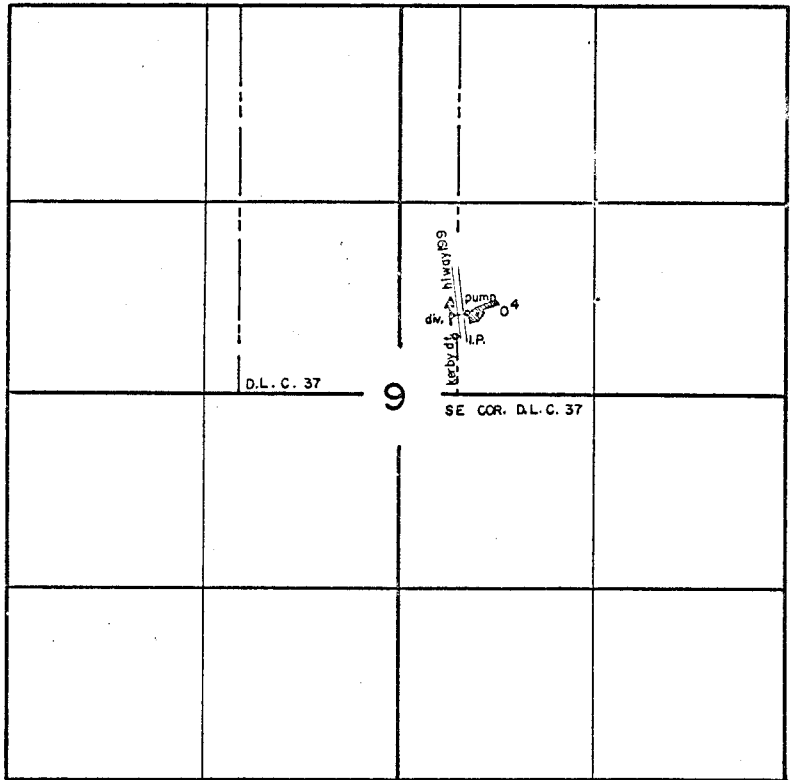

FINAL PROOF SURVEY UNDER

Application No. 37662 Permit No. 28072
IN NAME OF

.....ARTHUR and JOY KELLERT.....

Surveyed MAY 21 1964, by R.B. STEIMER.