


NW 1/4 NW 1/4 SEC. 1 T 26 S R 14 W

I BB

1 INCH 100'

BARVIEW  
BARVIEW ACRES

COOS BAY

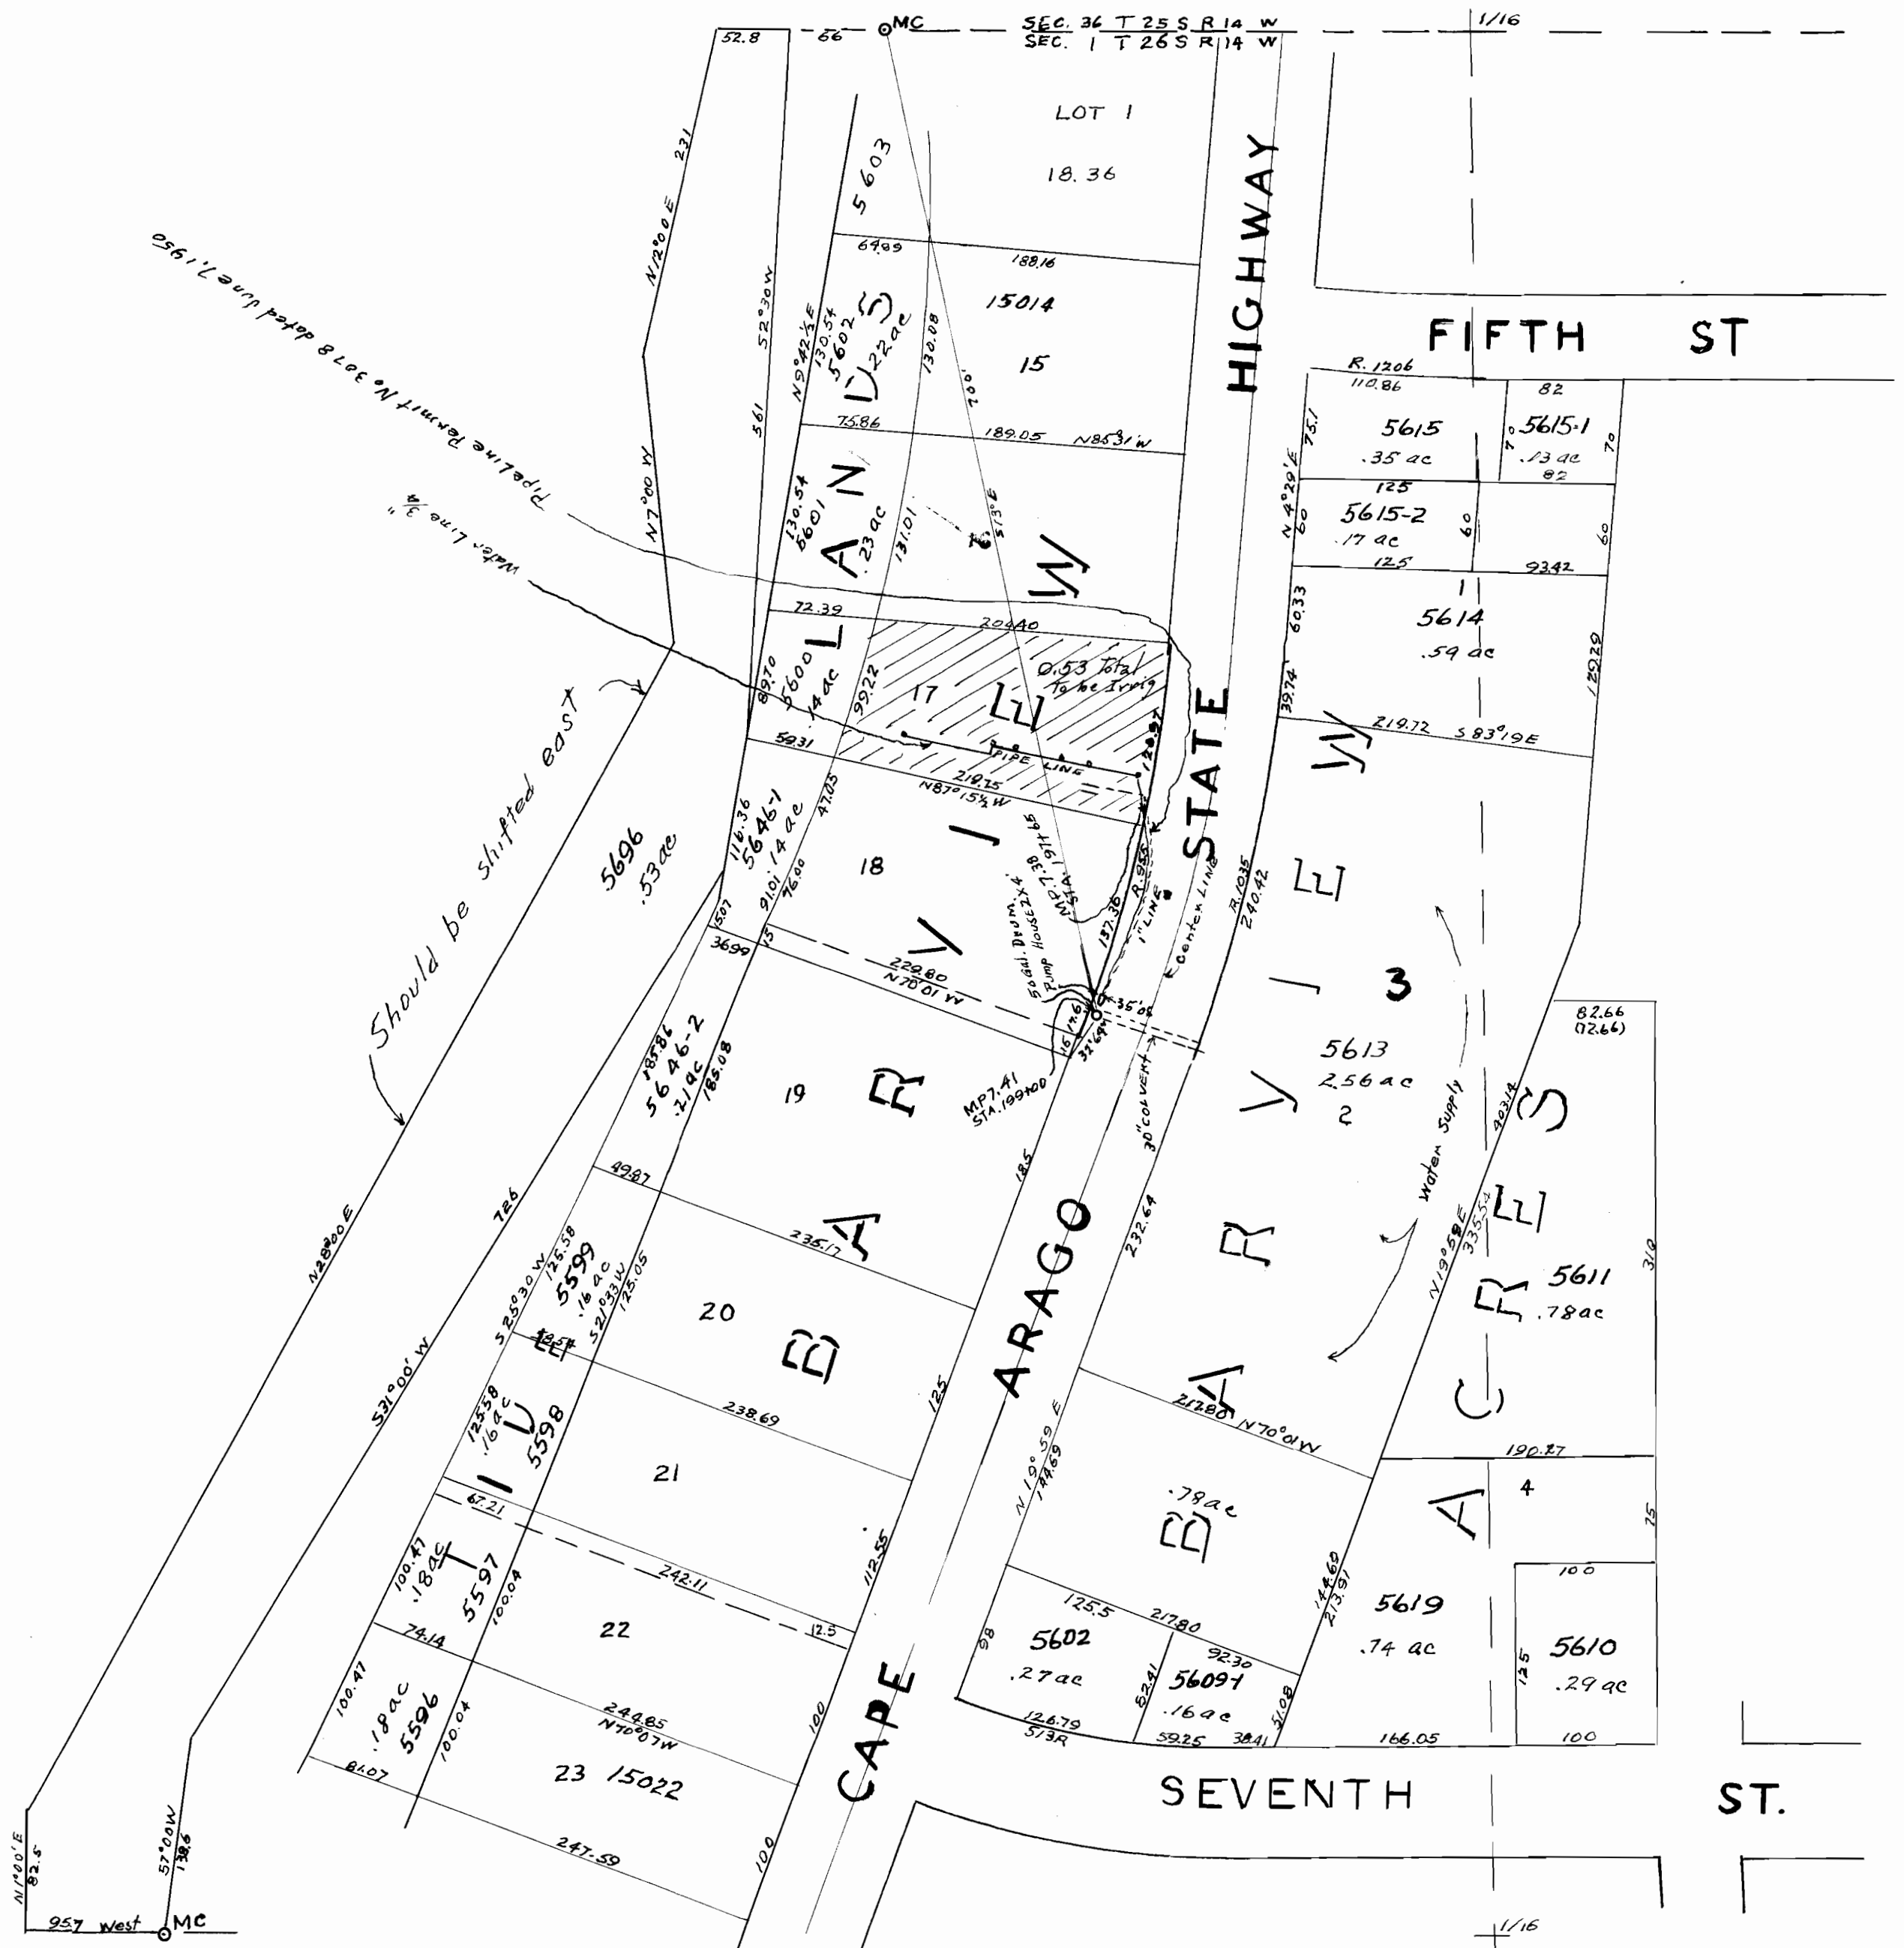

SEE MAP I BA 26 13

SEE MAP I BC 26 13

Application-37669  
Permit - 2011