


T.12S. R.26E. W.M.

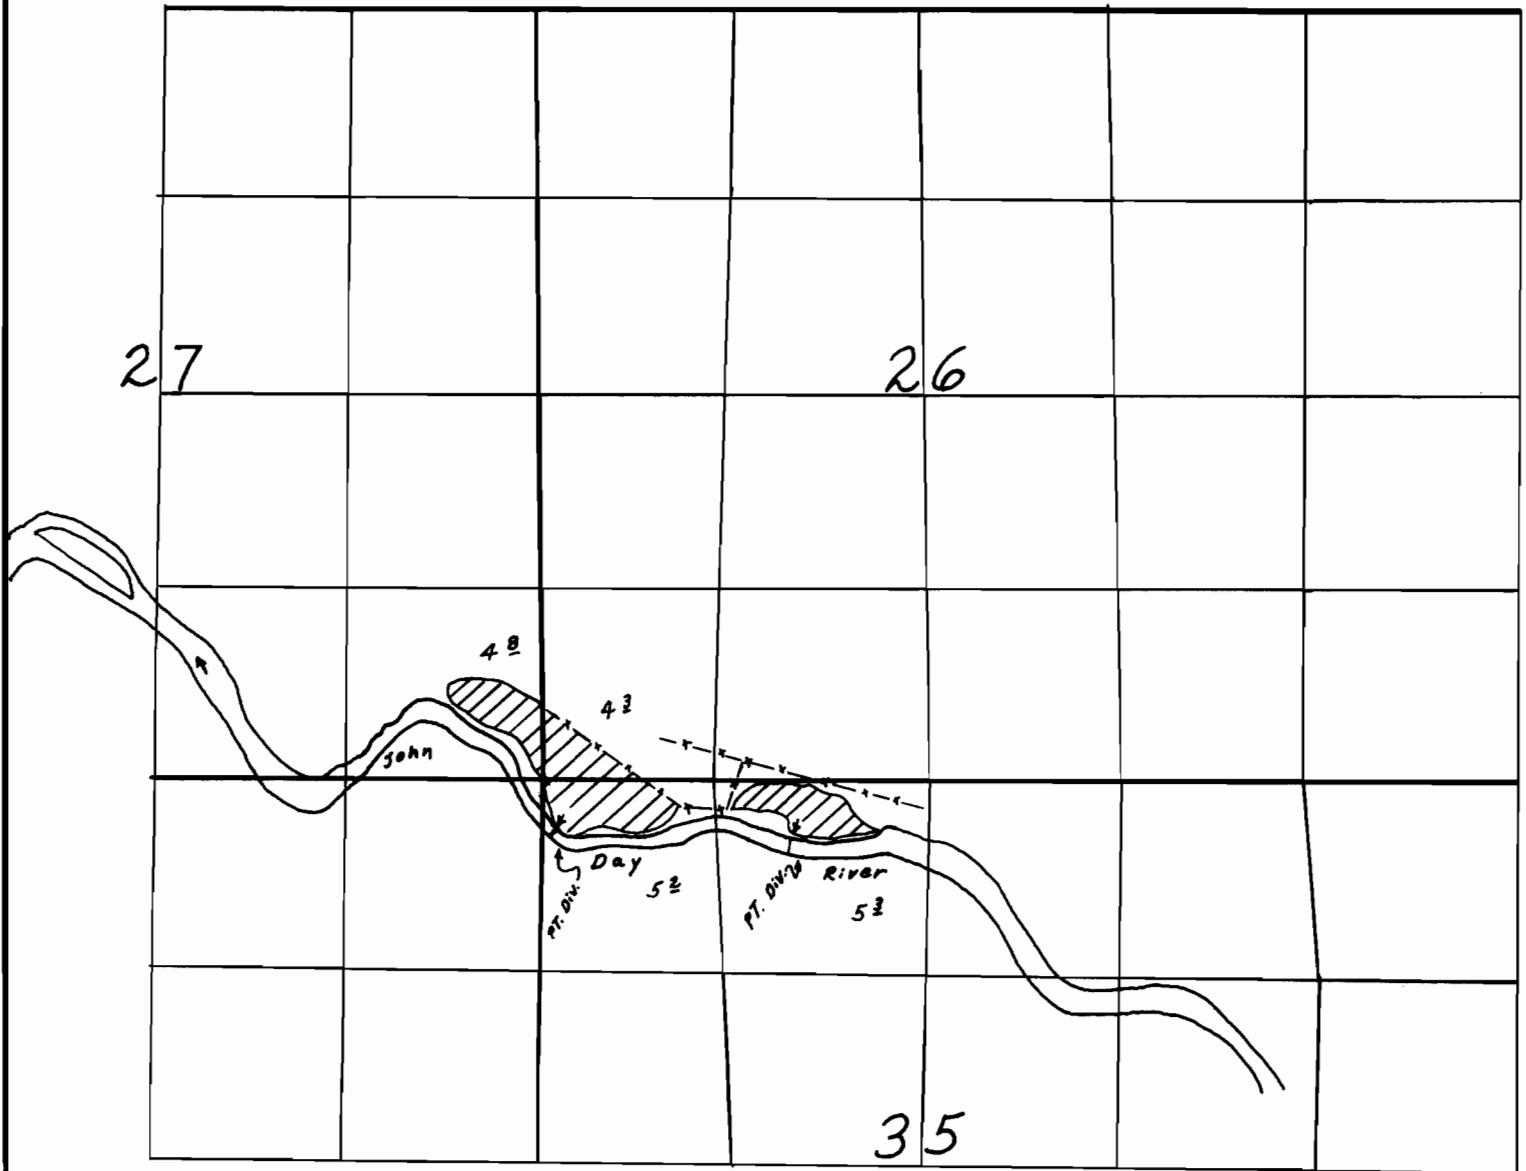

**FINAL PROOF SURVEY**  
UNDER

Application No. 37743 Permit No. 28131  
IN NAME OF

WALLACE JOHNSON

Surveyed June 24 1964, by G. Ward