


T. 35 S. R. 7 W. W.M.

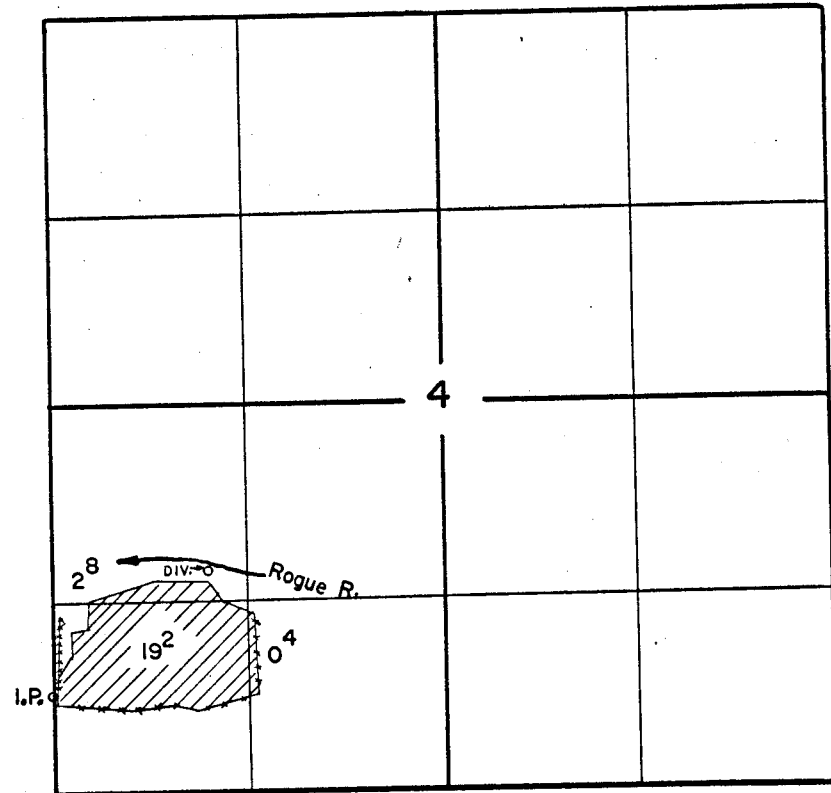

FINAL PROOF SURVEY UNDER

Application No. 37750 Permit No. 28135
IN NAME OF

RD. CO. COM. JOSEPHINE CO.

Surveyed JUNE 16, 1964, by R.B. STEINER