

27 26
34 35




COUNTY ROAD

S 0° 33' W
1451'

OREGON STATE FISH COMMISSION
WILEY CREEK FALLS FISHWAY

LOCATED IN THE NW 1/4 OF SEC. 35
T. 13 S., R. 1 E., W. M.
LINN COUNTY, OREGON

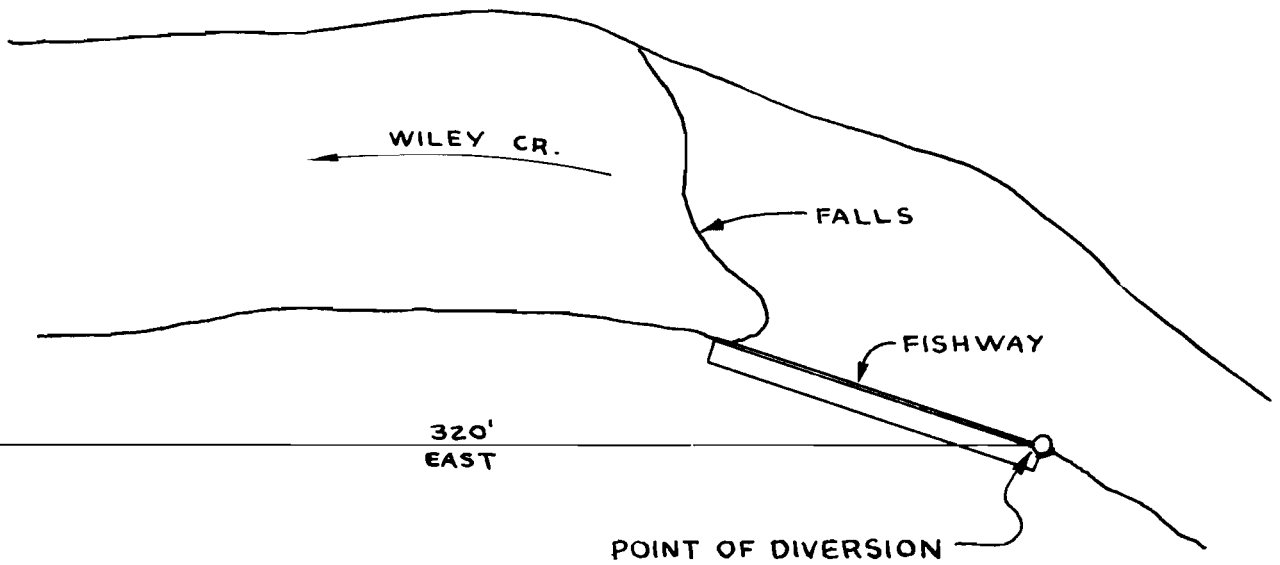

SCALE 1" = 50' Appleton No. 37601
Printed No. 28172