


4125  
4503

4503


Township 39 S., Range 5 W. W.M.

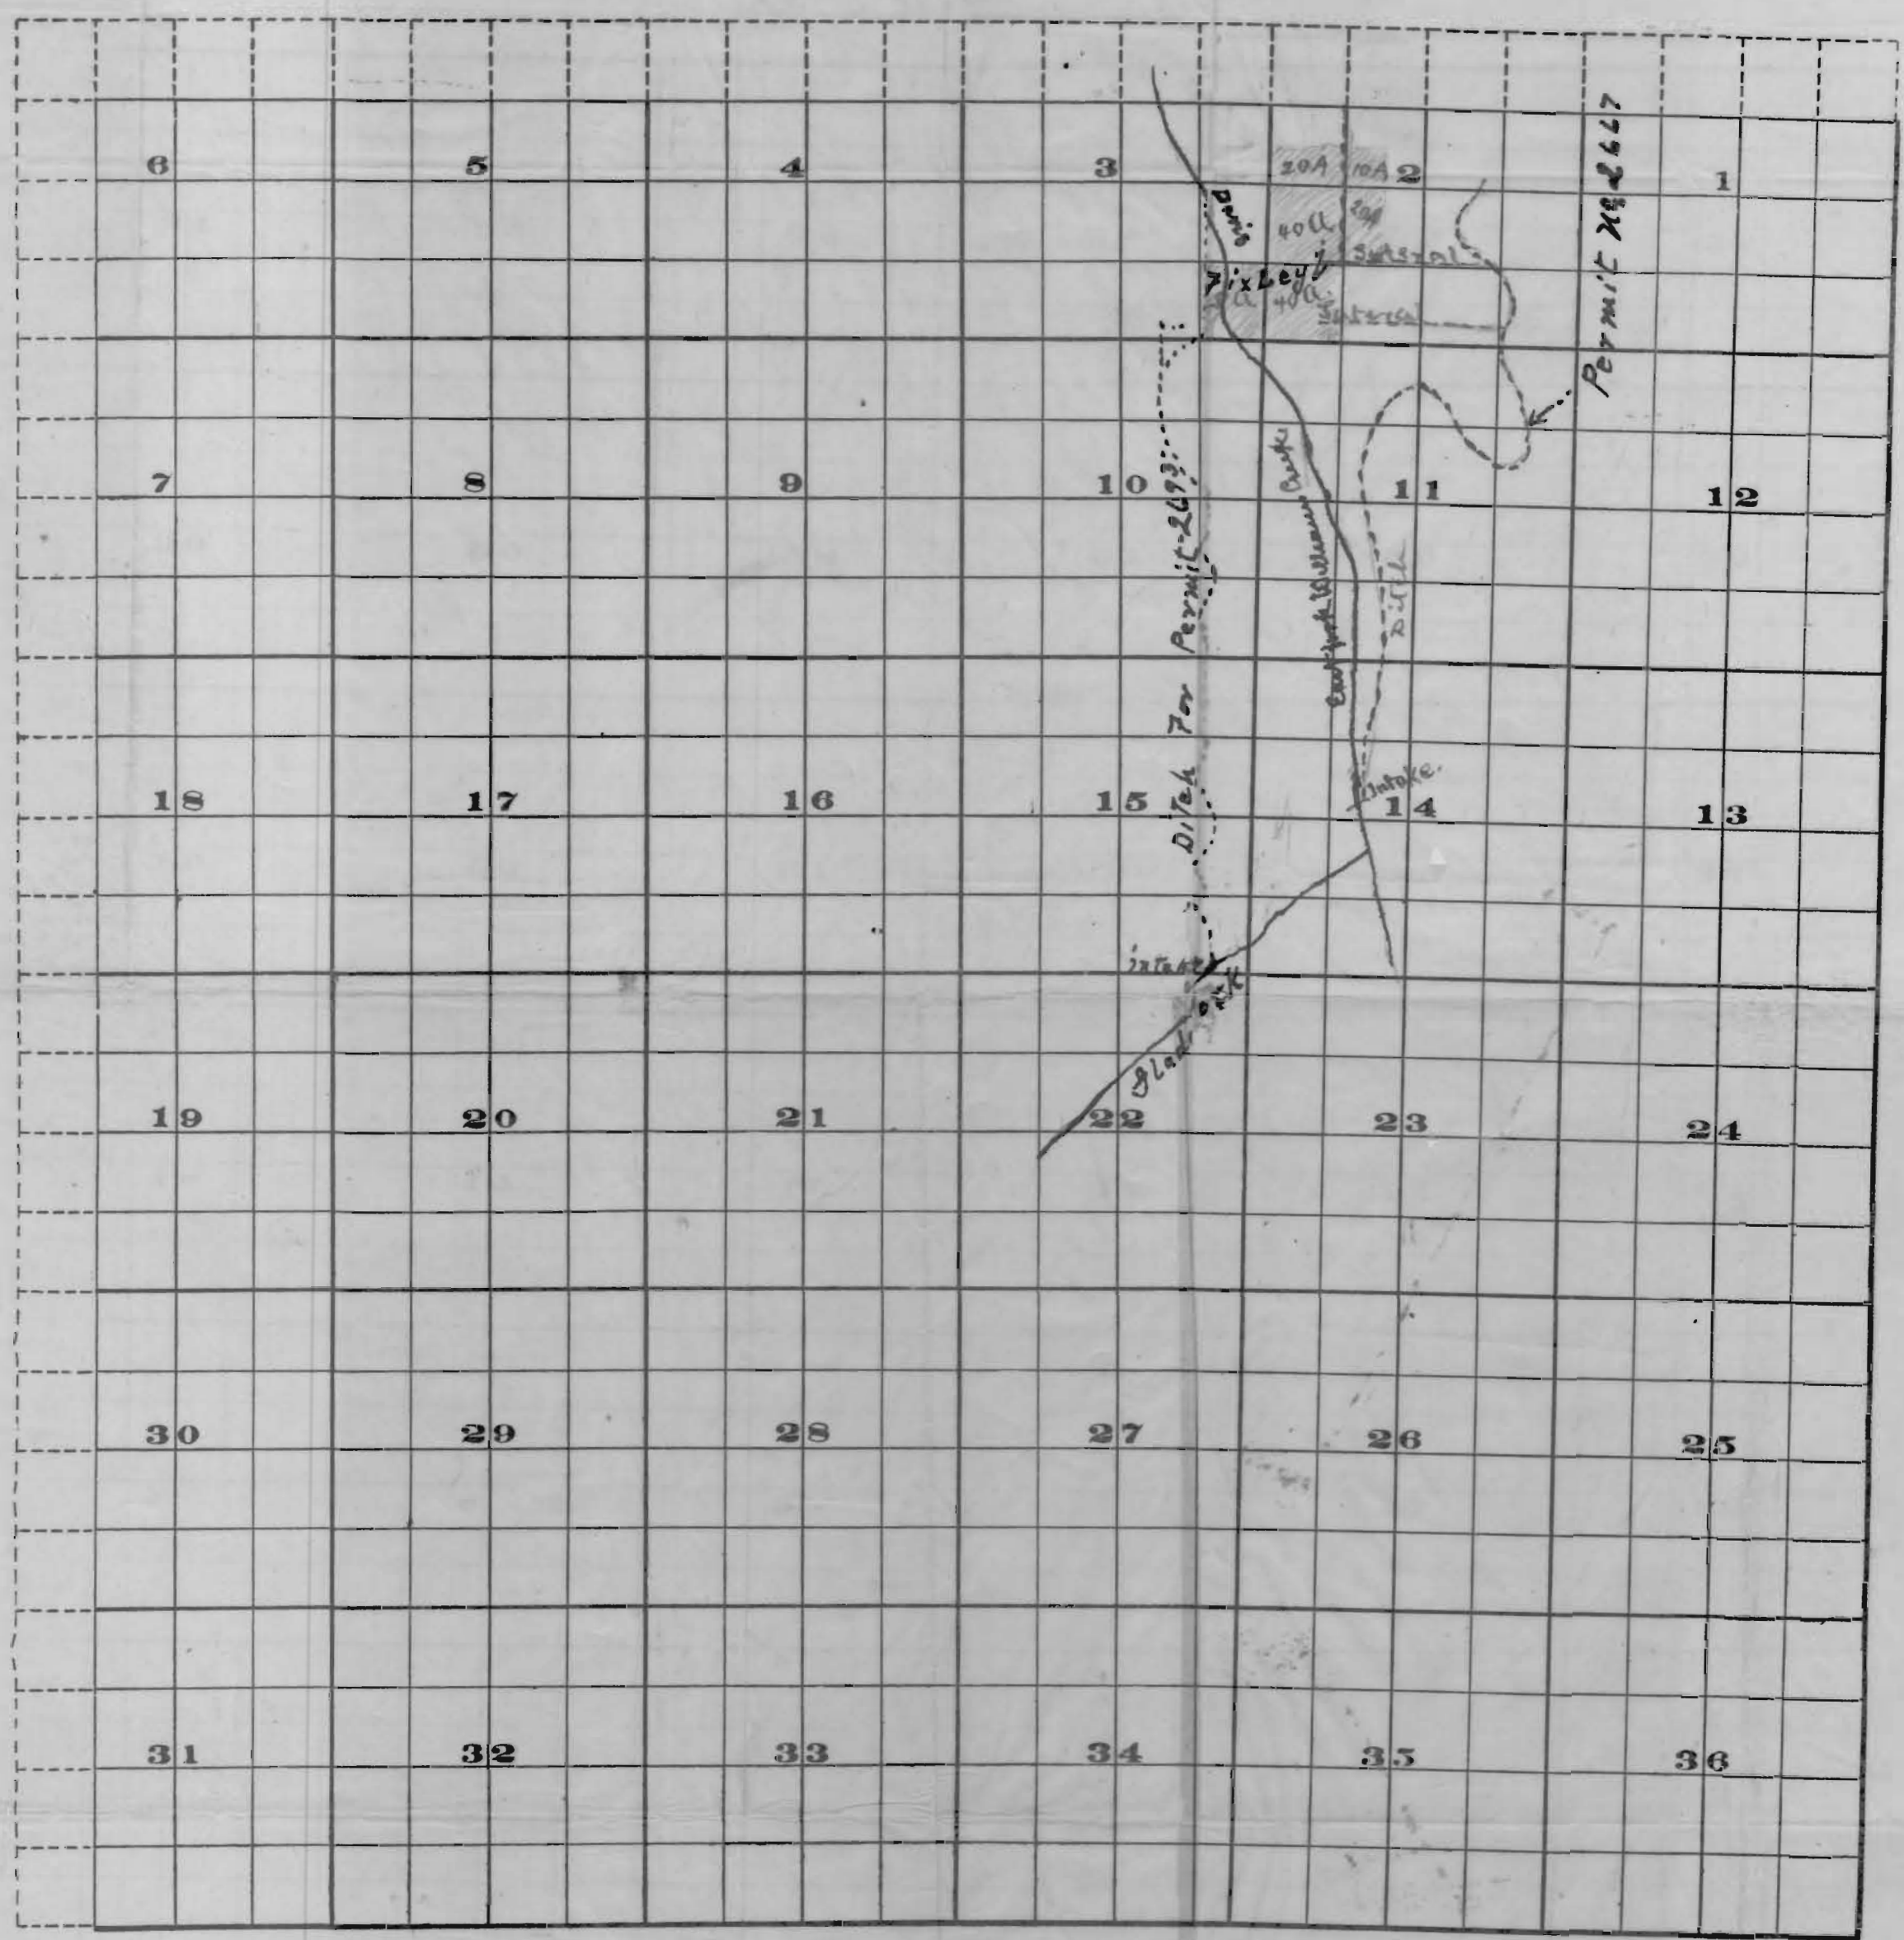

Permit 2667



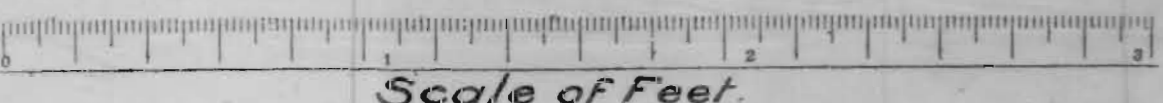

Scale of Feet.

FROM OFFICE OF THE STATE ENGINEER, SALEM, OREGON

*Amended Map*

OFFICE OF STATE ENGINEER  
RECEIVED  
FEB 15 1916  
SALEM, OREGON

Application No. 476  
Permit No. 2822

Amended  
Application No. 4503  
Permit No. 2667

OFFICE OF STATE ENGINEER  
RECEIVED  
SEP 10 1915  
SALEM, OREGON

4125  
4503

Amended Map - Dept. of Public Works

4125  
4503

4125