


T.33S.R.5W.W.M.

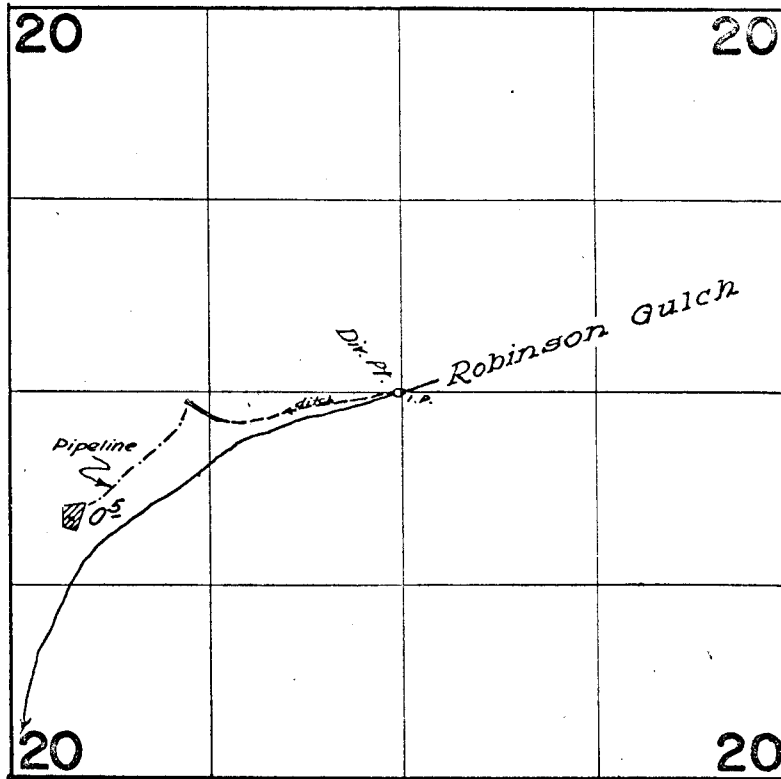

FINAL PROOF SURVEY
UNDER

Application No. 38037. Permit No. 28346.
IN NAME OF

HAROLD M^CINTOSH

Surveyed July 10, 1963, by

[Signature]