


T.40S.R.000W.M.M.

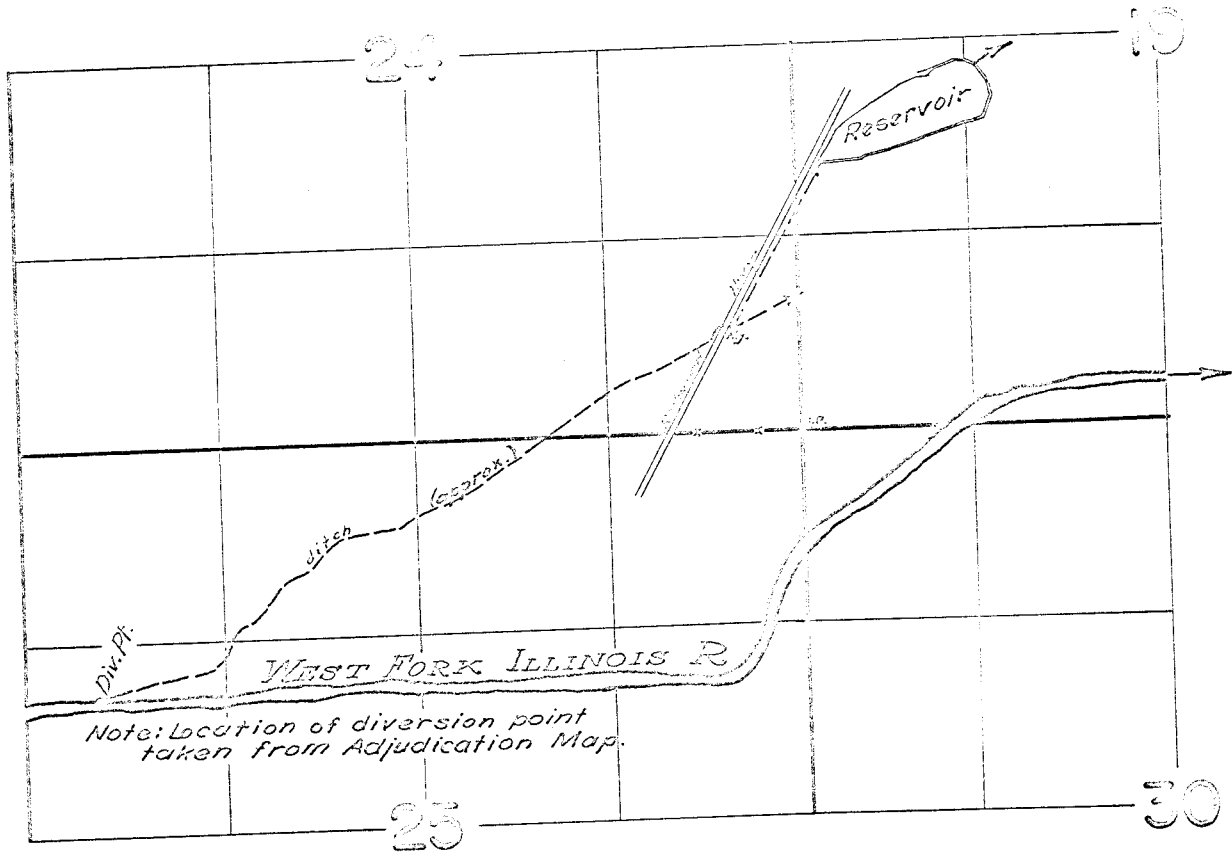

FINAL SHEET OF SURVEY
UNDER

R-37008 R-3160
Application No. 57352 Permit No. 20353
IN NAME OF

DELBERT O'BRIEN & CHARLIE A. TREFETHEN

Surveyed July 13, 1963, by *R. J. [Signature]*