


T. 36S. R. 5W. W.M.

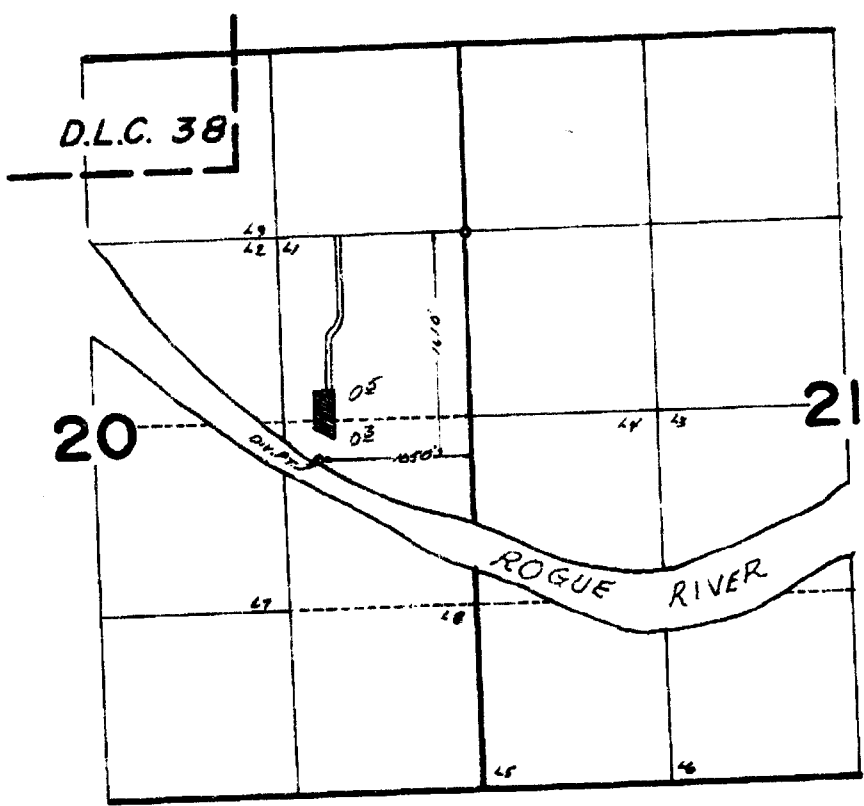

FINAL PROOF SURVEY UNDER

Application No. 37971..... Permit Nos 28429
IN NAME OF

..... DONALD R. SMITH

Surveyed June 21, 1965, by R.H. JACKSON

1965-C 577