


Ernest O. Webb

(Irrigation)

RECEIVED  
DEC 10 1962  
STATE ENGINEER  
SALEM, OREGON

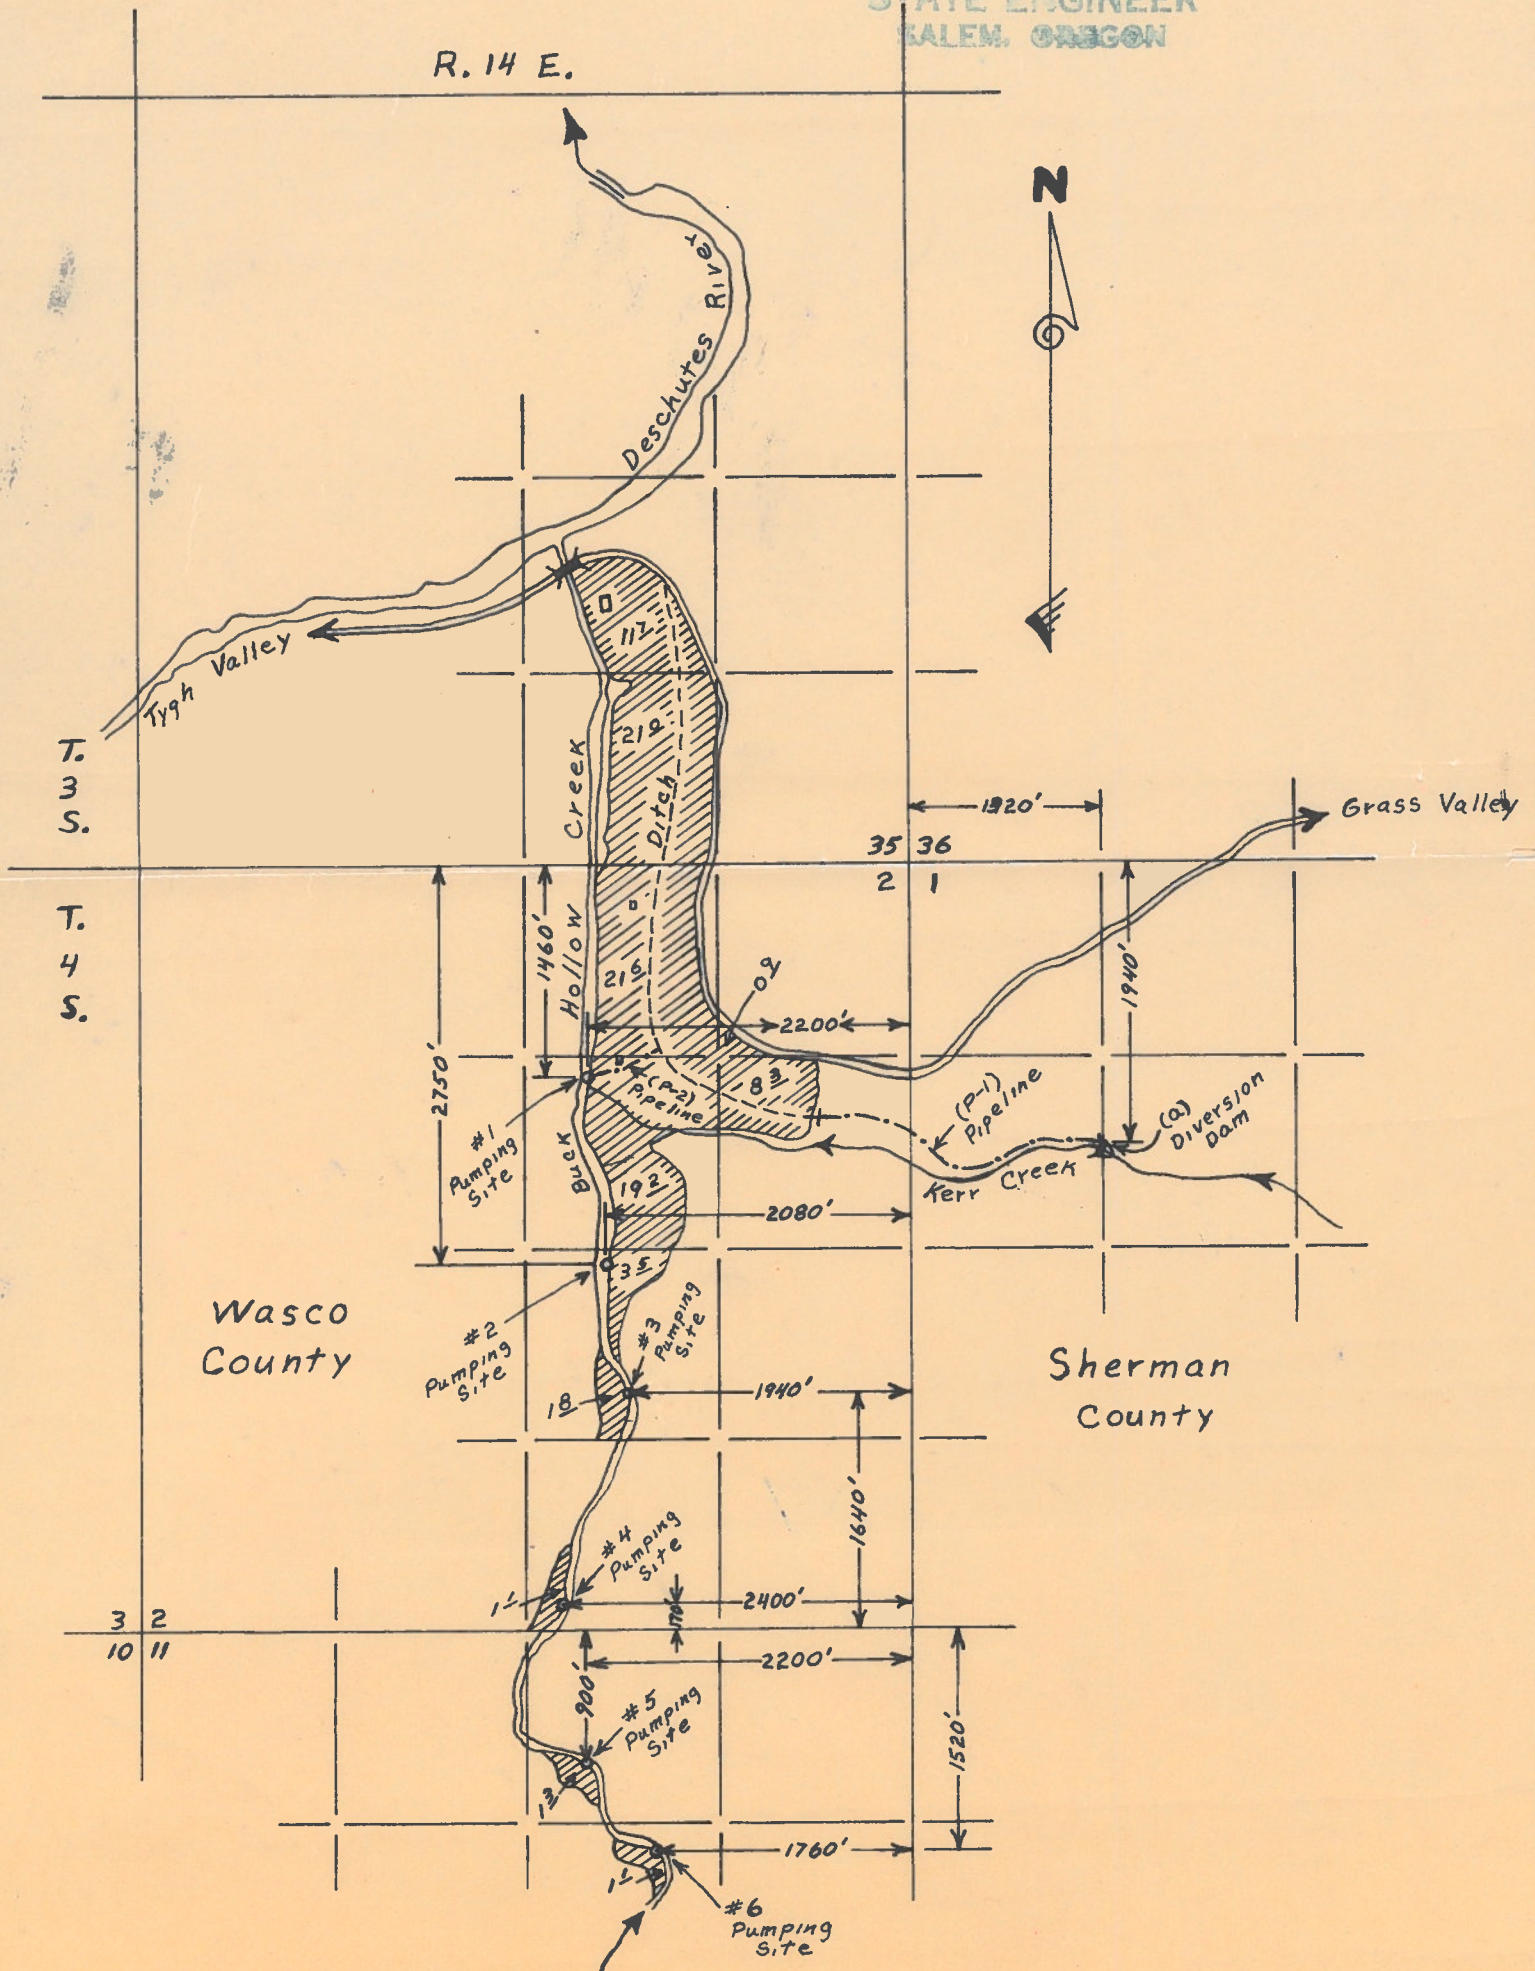

Scale 4" = 1 mile

Map Compiled From Aerial Photo  
Number AAE-SF-64  
(8-16-49 Flight)

Application No: 38284  
Permit No: 28518