


T.35S.R.7W.W.M.

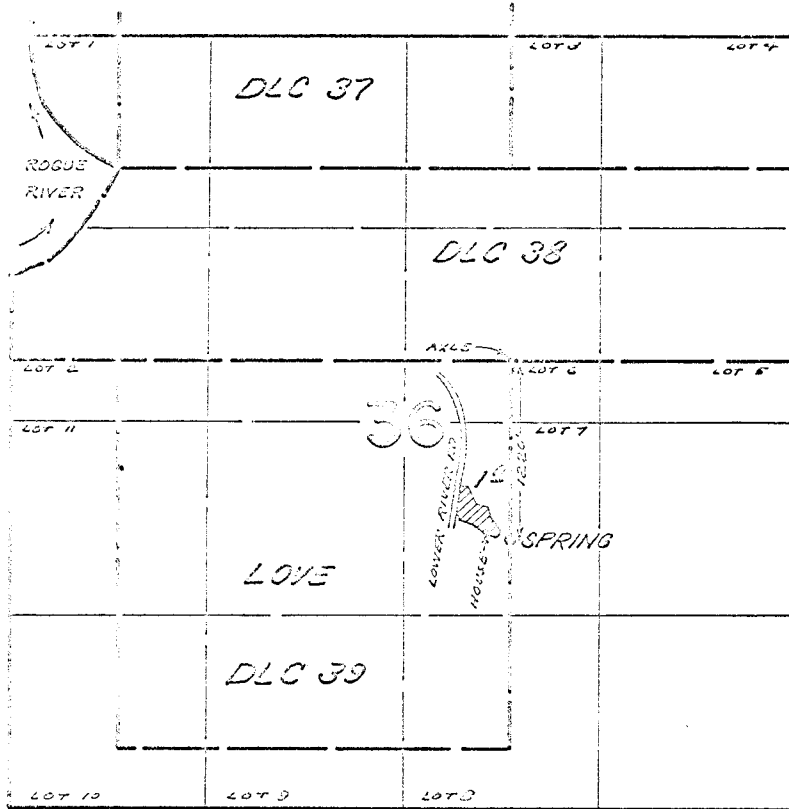

FINAL PROOF SURVEY  
UNDER

Application No. 97755 Permit No. 28550  
IN NAME OF

JOHN DANIEL & IDA BELLE SIMPSON

Surveyed JUN. 11, 1969 by D. BUELL