


15
28
7/1

T.36 S.R. 6 W.W.M.

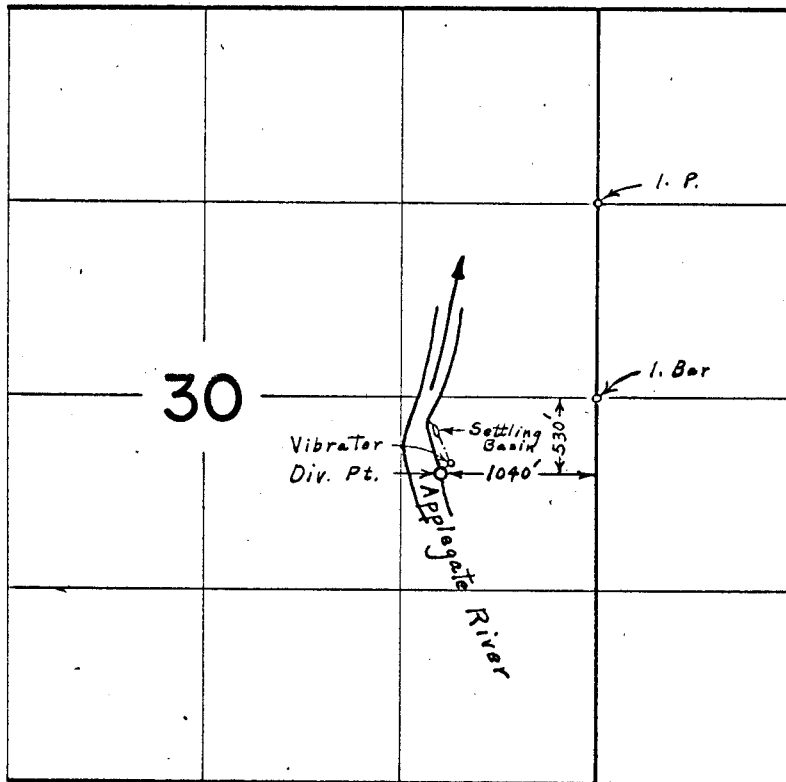

FINAL PROOF SURVEY UNDER

Application No. 38391 Permit No. 28606
IN NAME OF

H. F. SHAW dba REDIMIX CONCRETE CO.

Surveyed Aug. 30, 1967, by L. E. Gould