


T&S. R. I. W. W. M.

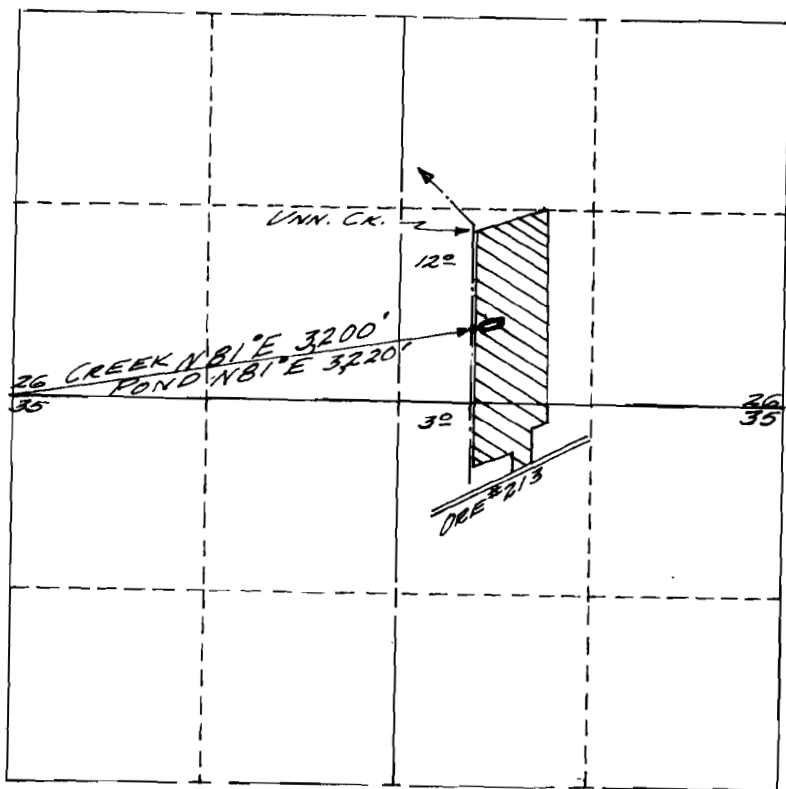

DFN 10-34

1" = 1320'

MERLE W. BETHSCHEIDER

SILVERTON, ORE.

Applicant

38412, R-38413

Permit

28611, R-3211