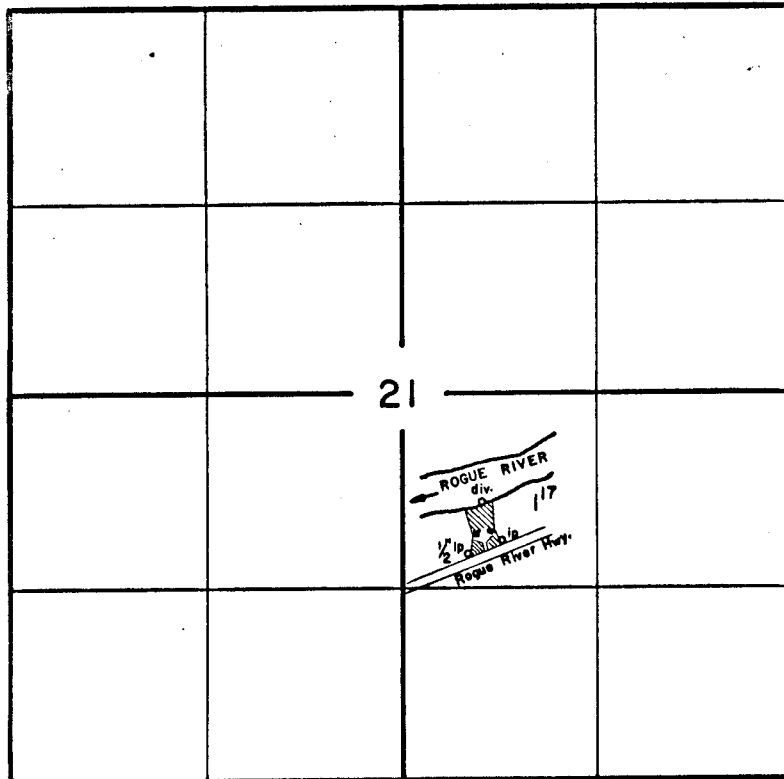


T. 36 S. R. 5 W. W.M.

**FINAL PROOF SURVEY**
UNDERApplication No. 38467... Permit No. 28644...
IN NAME OF

.....JOHN WILSON.....

Surveyed Feb 24... 1965... by R.B. Steimer.....