


Permit: S 28695
Volume: 5
Strm: BANNISTER CR/RES
Trib: JUMPOFF JOE CR
Priority: 1/31/62

T.35S.R.6W.V Cert. # 34359

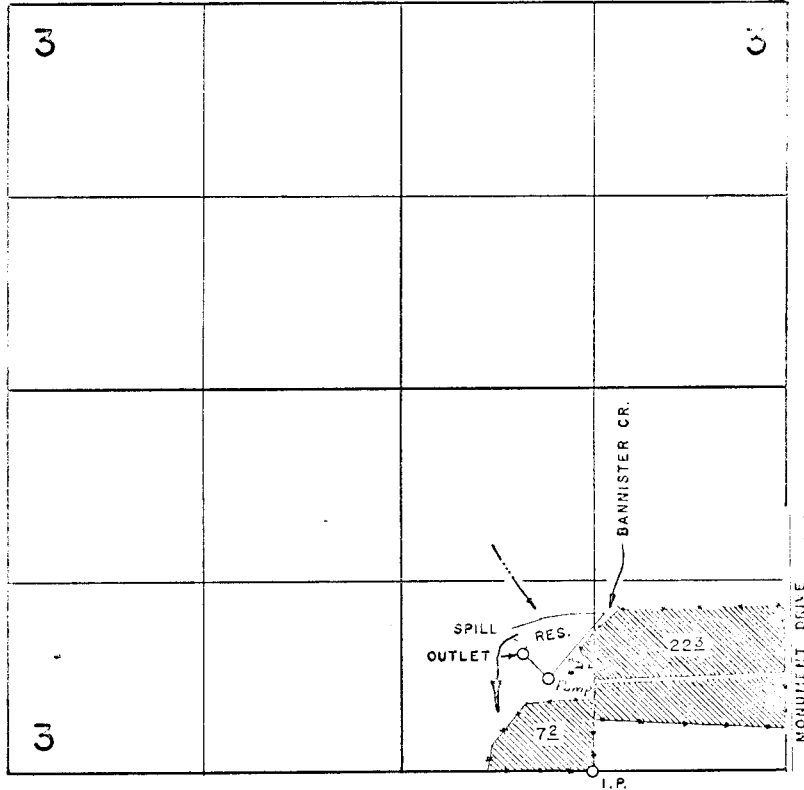

Div. Pt. located 800 ft. N. & 480 ft. W. from
the S.E. Cor. SW 1/4 SE 1/4 Sec. 3

FINAL PROOF SURVEY
UNDER

R-37371 R-3246
Application No. 37372 Permit No. 28695
IN NAME OF

.....
JOEL L. BARKER
.....

Surveyed May 23, 1967, by R.B. STEIMER