


T.35S.R.7W.W.M.

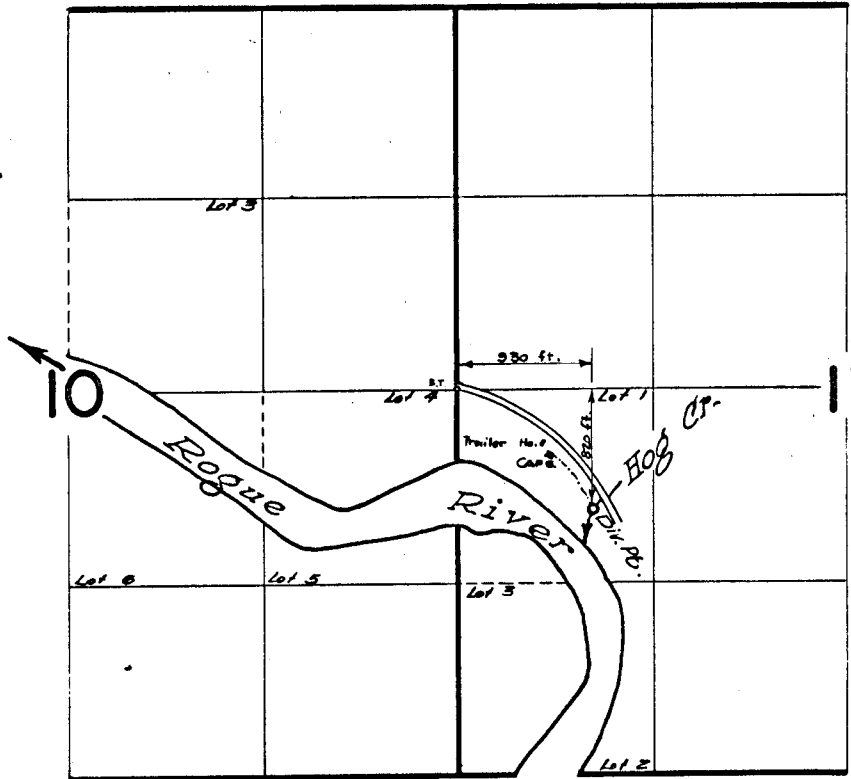

FINAL PROOF SURVEY UNDER

Application No. 38464... Permit No. 28806...
IN NAME OF

CHARLES H. & HAZEL P. DARCEY

Surveyed July 13, 1965, by *A. Jackson*