


T. 36 S. R. 7 W. W.M.

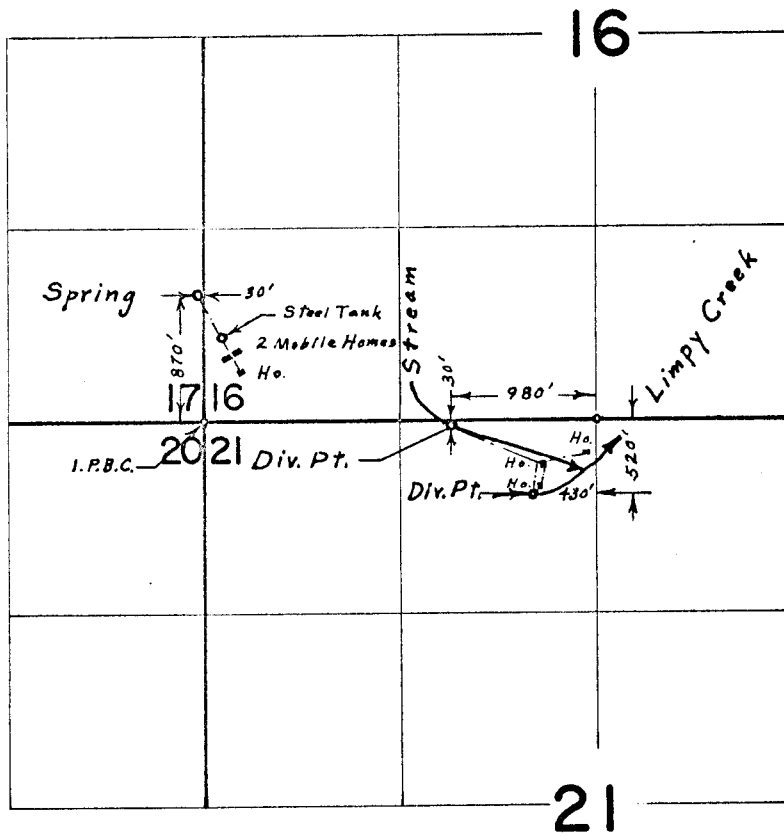

FINAL PROOF SURVEY

UNDER

Application No. 37 775 Permit No. 28869

IN NAME OF

J. Z. WALKER

Surveyed May 1, 1970, by L. E. Gould