

Application No. 673

Permit No. 290


N.

W

E

35

36

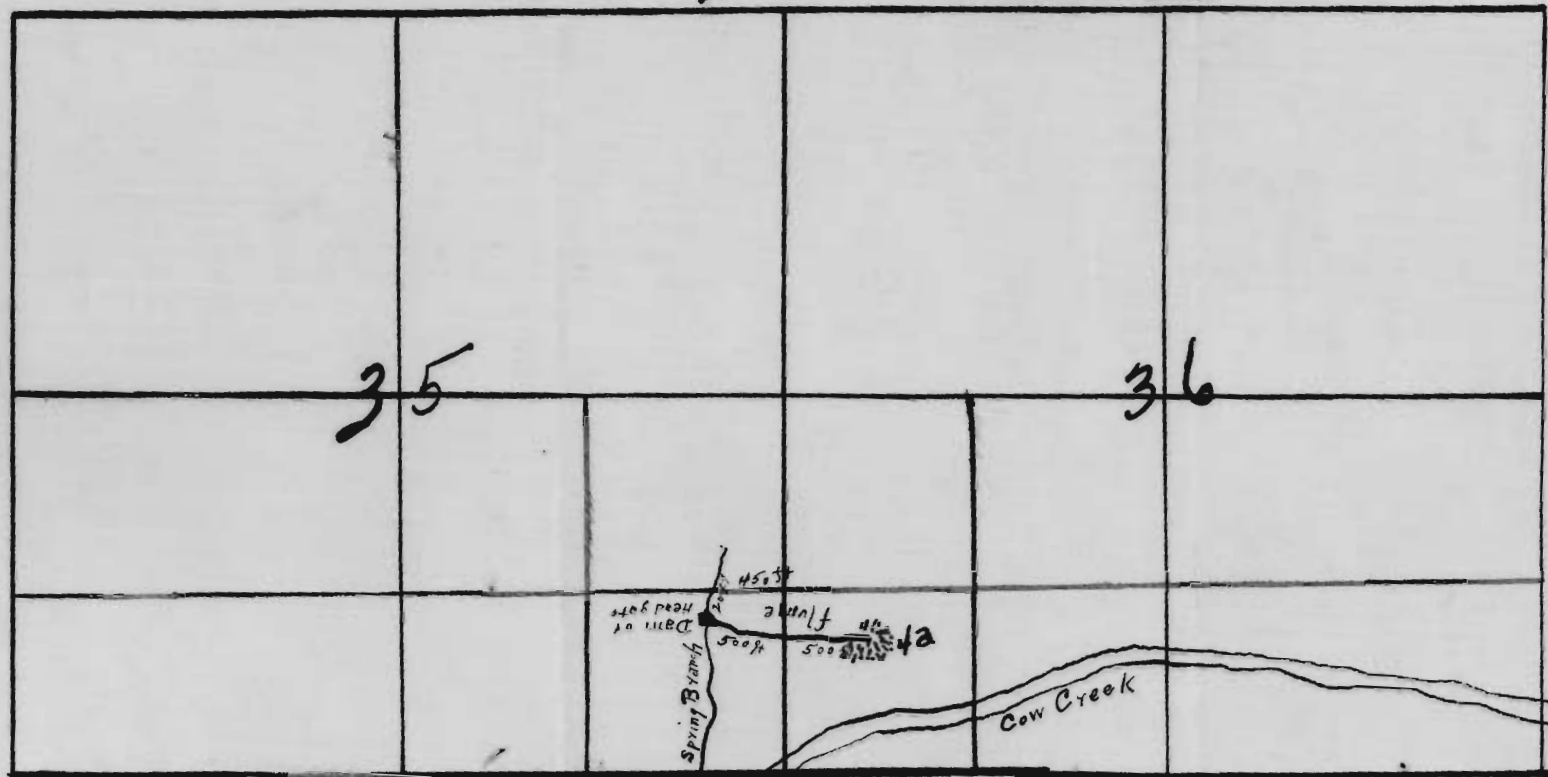

Jennings Flume or Ditch S.

Tp. 32 S. R. 7 W. W.M. Douglas County, Oregon