


29091

25-4-76

# T. 35 S. R. 7 W. W. M.

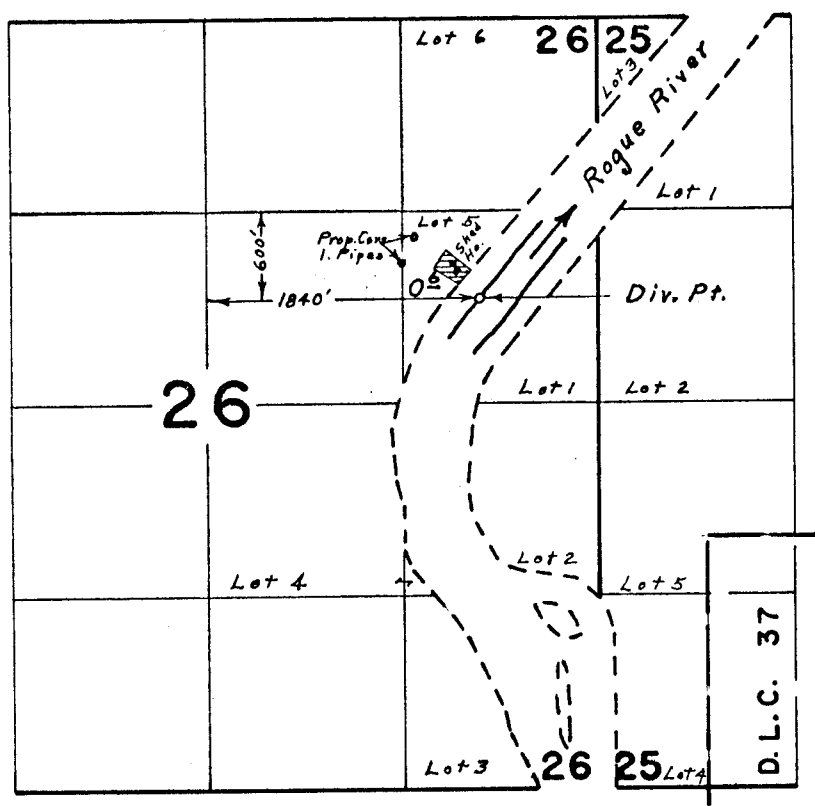

## FINAL PROOF SURVEY

UNDER

Application No. 39065 Permit No. 29091

IN NAME OF

MATTHEW W. & FRANCES H. THOME

Surveyed April 15 1970, by L. E. Gould