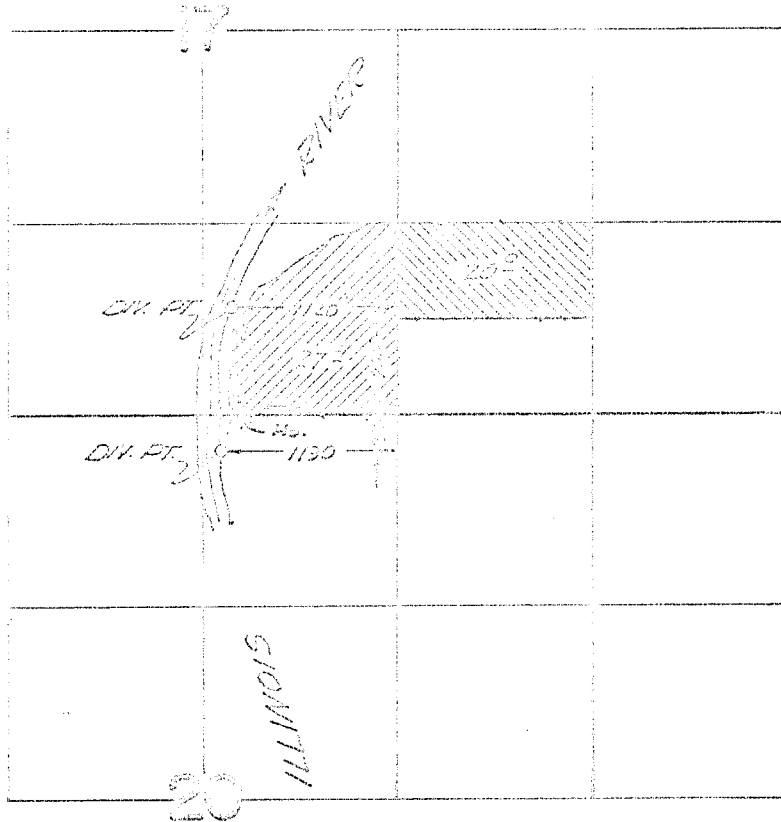


Permit: S 29173  
Volume: 8  
Strm: ILLINOIS R  
Trib: ROGUE R  
Priority: 9/12/63

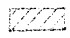
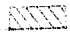
3

7352 R.O. 11/11/11

20



FINAL PROOF SURVEY  
UNDER

37416      27865   
Application No. 39021      Permit No. 29173   
IN NAME OF

CHARLES NEIL VERSTEEG

Surveyed May 17, 1967, by V. Gardner

1557 B