


15
Per. 29181

36-6-27

T.B.S.R.6 W.W.M.

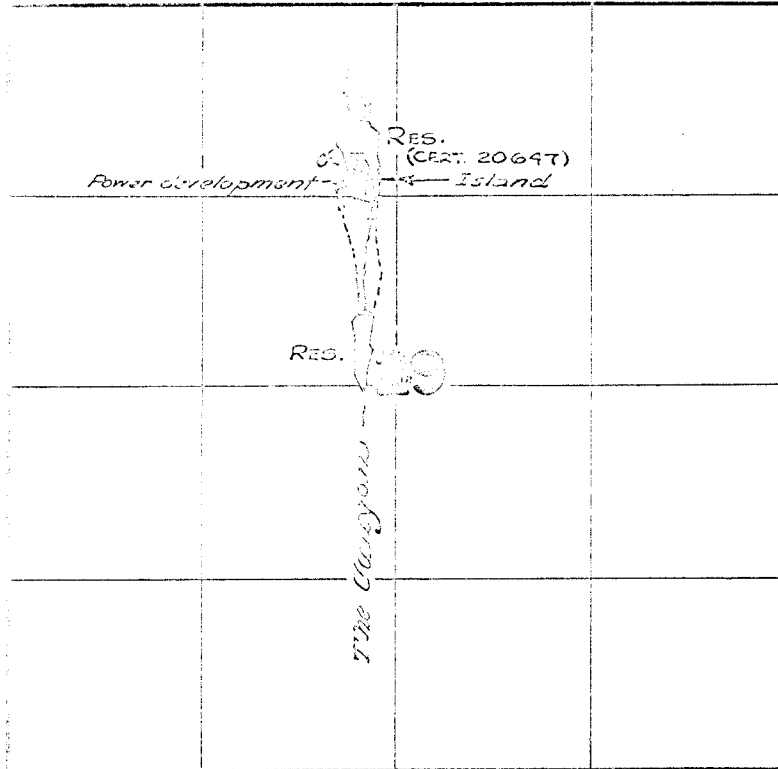

FINAL PROOF SURVEY
UNDER

R-30911 R-3035
Application No. 30135 Permit No. 29181
IN NAME OF

C. VERN WHITE

Surveyed June 25, 1965, by *R. Johnson*