


R-3884
29201
36

T.36S.R.6W.W.M.

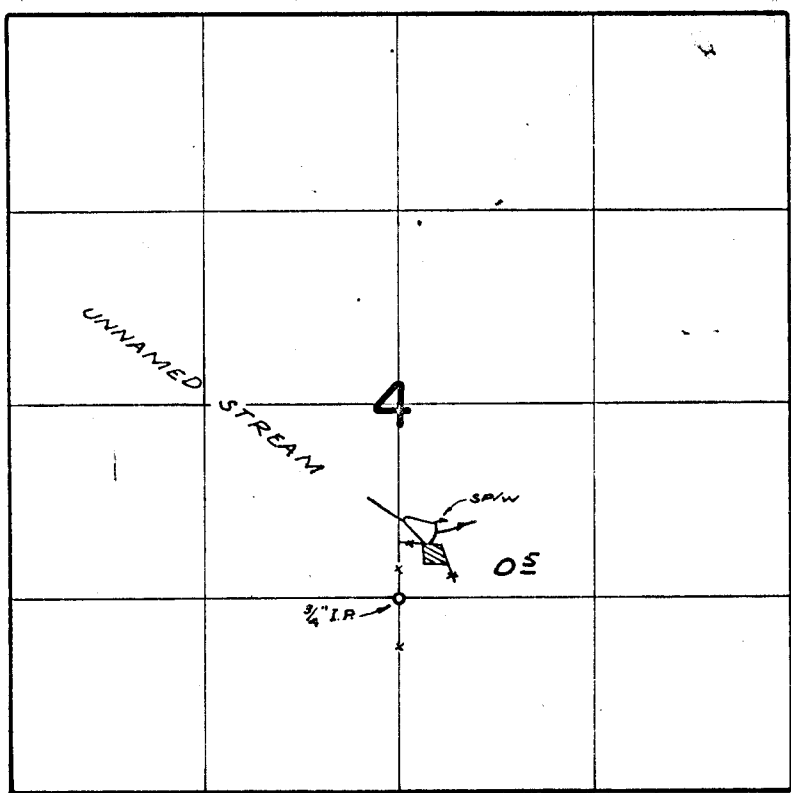

DIV. PT. LOC: 440' N. & 250' E. FROM S.W. COR. NW 1/4 SE 1/4 SEC. 4

FINAL PROOF SURVEY
UNDER

Application No. ^{R-38880} ~~38881~~ Permit No. ^{R-3884} ~~29201~~
IN NAME OF

.....G. P. STEPPE.....

Surveyed APR. 14, 1972, by R. MUCKEN

C-39622-27684