


PACIFIC OCEAN

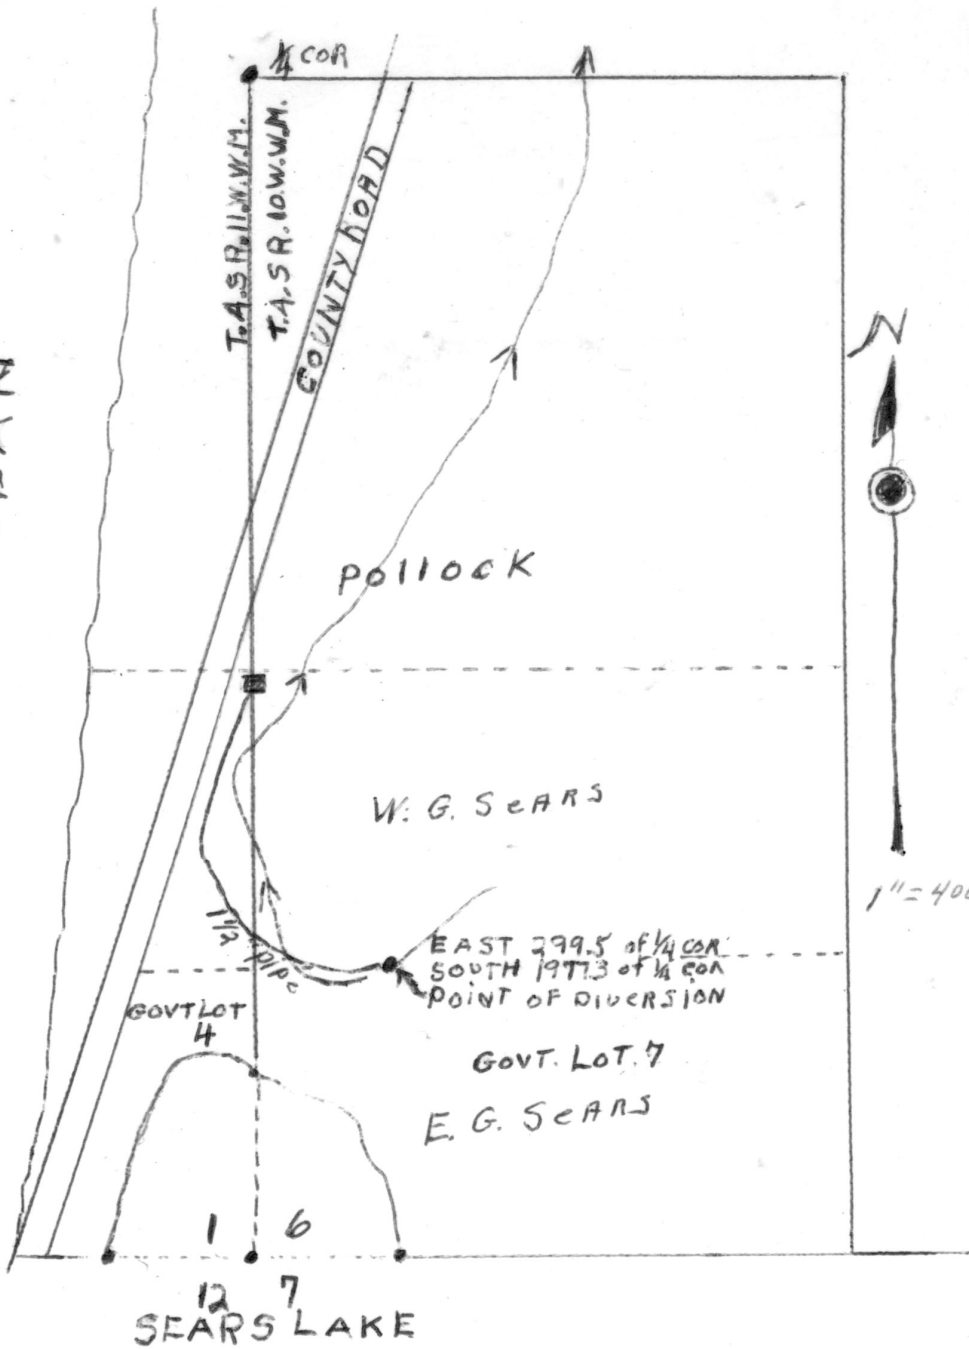

Application No. 39262  
Permit No. 29245