


29338

1-3-21

T39S. R.8W. W.M.

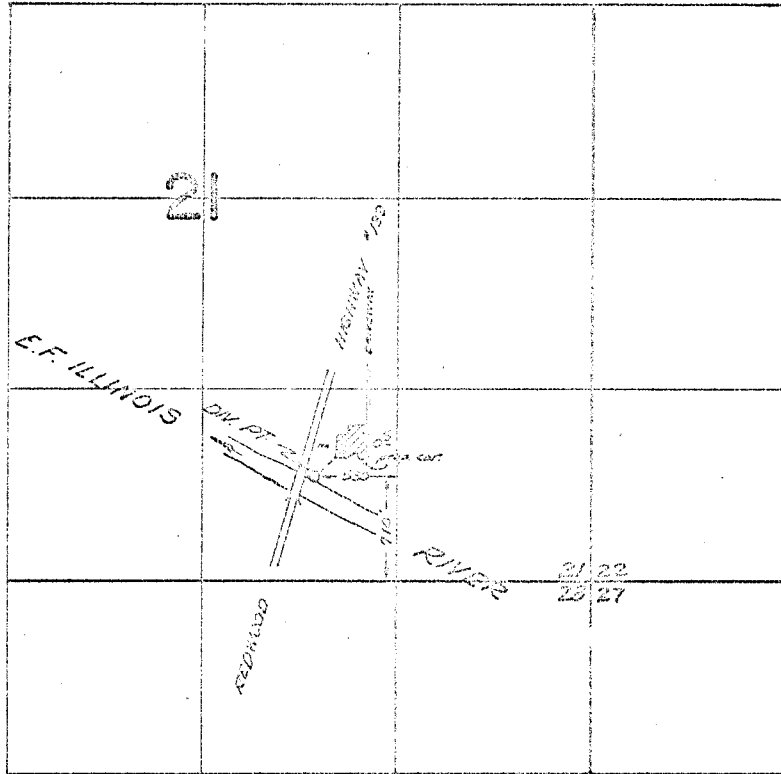

FINAL PROOF SURVEY
UNDER

Application No. 38952 Permit No. 29338
IN NAME OF

Mrs. DORIS A. BOYD

Surveyed May 16, 1967, by V. Garner