


Est. 15
Permit 29352
37-7-1

*Map of ...
slat ...*
T. 37 S. R. 7 W. ...

SECTION 1

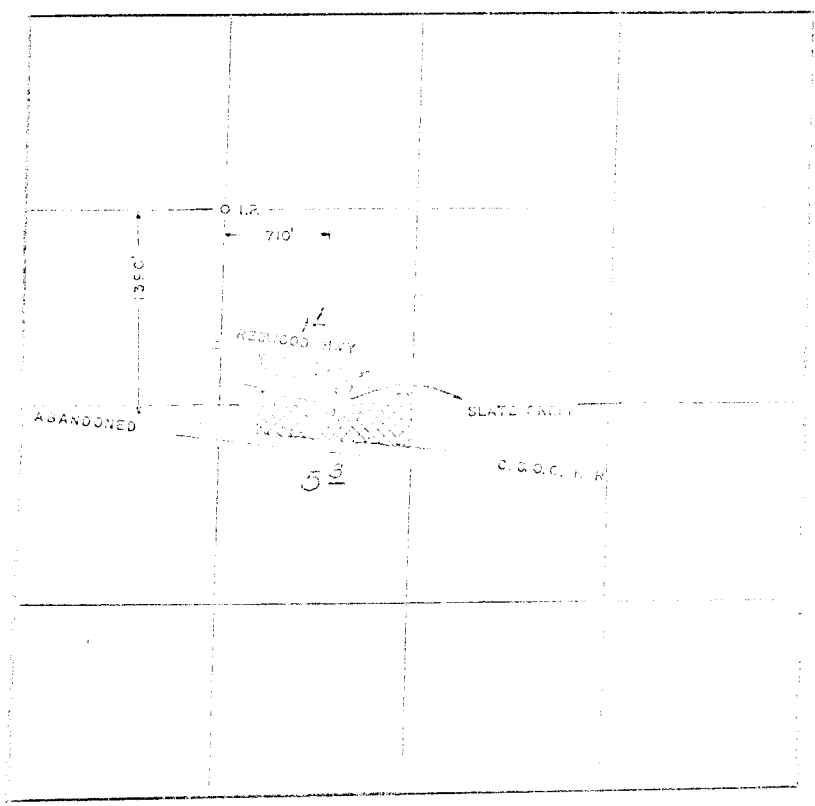

20000 APRIL 1966
CERTIFICATE 20000

[Handwritten signature]
PERMIT 29352

UNDER

Application No. 30888 Permit No. 28702
IN NAME OF

JOE L. S. ELIZABETH A. ...

Surveyed APRIL 2 1966, by R. G. STEWART

1-16-67

30888