


Per. 29403

35-7-35

T.35S.R.7W.W.M.

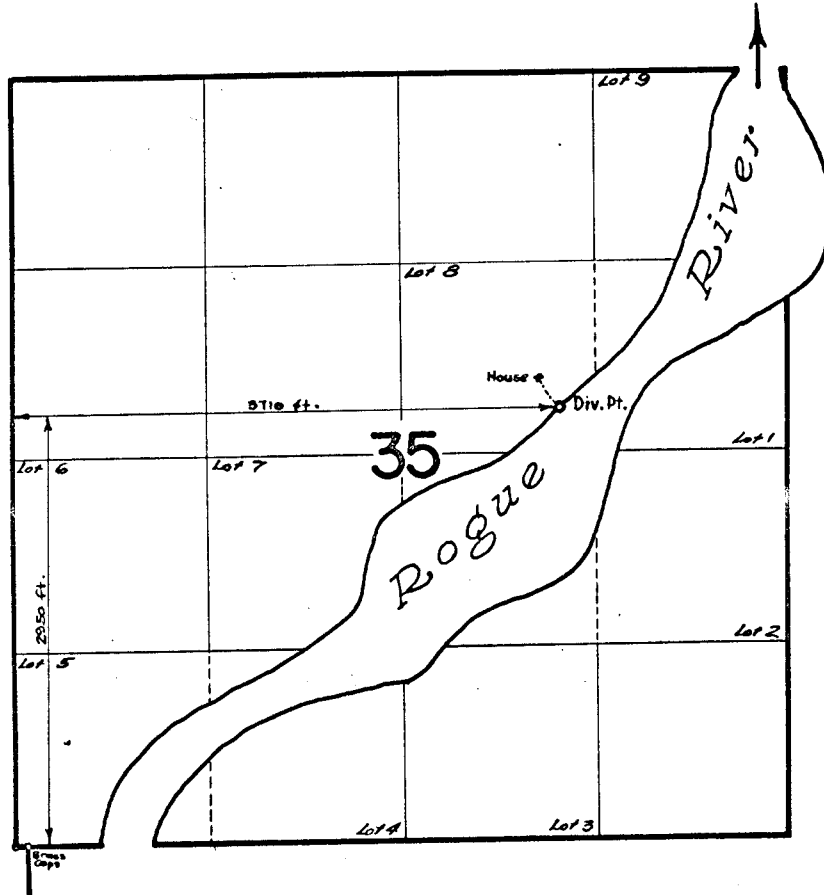

FINAL PROOF SURVEY UNDER

Application No. 39519.... Permit No. 29403...
IN NAME OF

JOHN WALTER MCLOUGHLIN

Surveyed July 13, 1965, by R. Jackson