


32-6-14 15
29526

T. 33S.R. 6W.W.M.

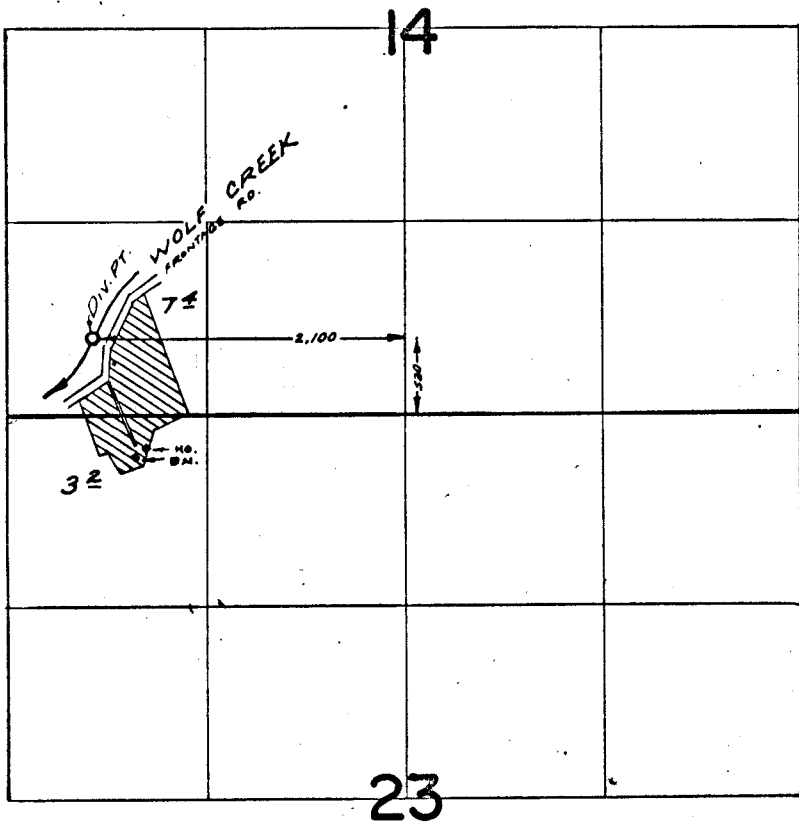

FINAL PROOF SURVEY UNDER

Application No. 39662 Permit No. 29526
IN NAME OF

MRS. CLARENCE BENSCH

Surveyed APR. 17, 1970, by R. MUCKEN