


29530

T.33S. R.6W. W.M.

RECEIVED

NOV 24 1976

WM. DIST. 14  
GRANTS PASS. ORE.

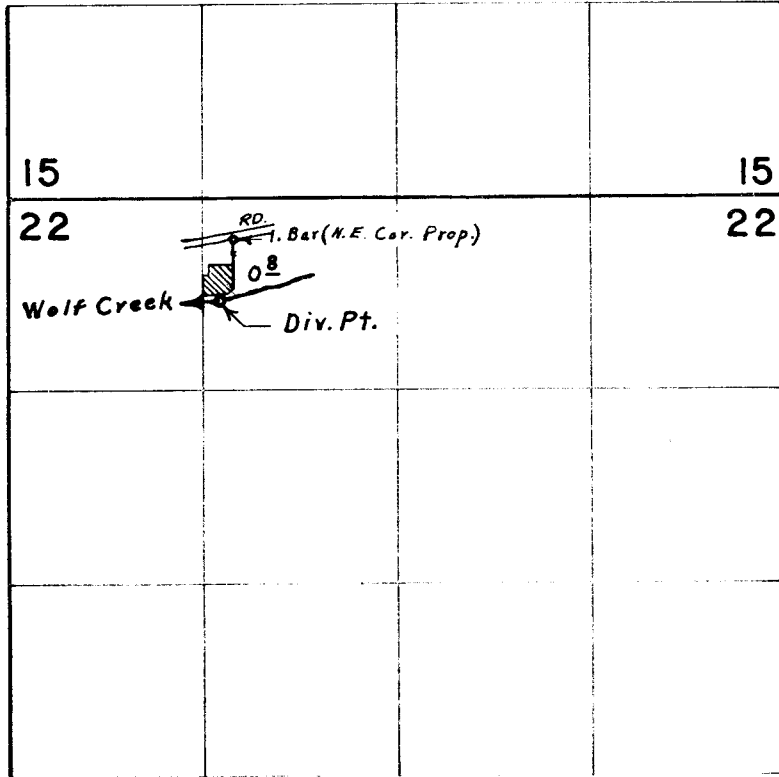

Div. Pt. located 700' S. & 1438' E. from N.W. Cor. Sec. 22

**FINAL PROOF SURVEY**  
UNDER

Application No. 39668 Permit No. 29530  
IN NAME OF

**CHARLES & AGNESS MERRILL**

Surveyed May 13, 1974, by L. E. Gould